


STATE OF KANSAS
STATE CORPORATION COMMISSION

Give All Information Completely
Make Required Affidavit
Mail or Deliver Report to:
Conservation Division
State Corporation Commission
800 Bitt Building
Wichita, Kansas

WELL PLUGGING RECORD

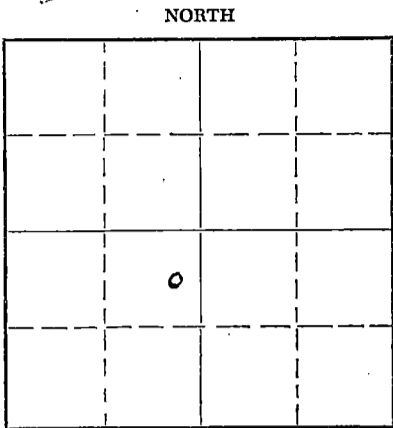

Locate well correctly on above
Section Plat

Rice County. Sec. 17 Twp. 18S Rge. 6 KEY (W) est
Location as "NE/CNW/SW" or footage from lines C E/2 NE SW
Lease Owner E. H. Riggs & Prime
Lease Name Sophia Taylor Well No. 1
Office Address 408 Rule Bldg., Wichita, Kansas
Character of Well (completed as Oil, Gas or Dry Hole) Dry Hole
Date well completed 6-20-54 19
Application for plugging filed 6-20-54 19
Application for plugging approved 6-20-54 19
Plugging commenced 6-20-54 19
Plugging completed 6-20-54 19
Reason for abandonment of well or producing formation Dry Hole

If a producing well is abandoned, date of last production None 19
Was permission obtained from the Conservation Division or its agents before plugging was commenced? Yes

Name of Conservation Agent who supervised plugging of this well Ruel Durkee
Producing formation None Depth to top Bottom Total Depth of Well 3499 Feet
Show depth and thickness of all water, oil and gas formations.

OIL, GAS OR WATER RECORDS

CASING RECORD

FORMATION	CONTENT	FROM	TO	SIZE	PUT IN	PULLED OUT

Describe in detail the manner in which the well was plugged, indicating where the mud fluid was placed and the method or methods used in introducing it into the hole. If cement or other plugs were used, state the character of same and depth placed, from feet to feet for each plug set.

Filled hole wit heavy drilling mud from 3499 feet to 135'; set plug and cemented with 15 sacks of cement; Filled hole with extra heavy drilling mud from 135' to 25'; set plug and cemented with 1 sack fiber-seal & 5 sacks cement.

RECEIVED
STATE OF KANSAS
CONSERVATION DIVISION
JUN 16 1954

(If additional description is necessary, use BACK of this sheet)

Name of Plugging Contractor Prime Drilling Company
Address 1005 Central Bldg., Wichita, Kansas

STATE OF Kansas, COUNTY OF Sedgwick, ss. Contractor
L. J. Clampitt (employee of owner) or (owner or operator) of the above-described well, being first duly sworn on oath, says: That I have knowledge of the facts, statements, and matters herein contained and the log of the above-described well as filed and that the same are true and correct. So help me God.

(Signature) BY L. J. Clampitt Sec. Treas.
1005 Central Bldg., Wichita, Kansas (Address)

SUBSCRIBED AND SWORN TO before me this 24th day of June, 1954.

My commission expires October 14, 1957.

24-7368-S 3-53-20M



PLUGGING
FILED SEC 17 T 18 R 6W
BOOK PAGE 42 LINE 21

Notary Public.

ROTARY DRILLING LOG

OPERATOR: Riggs & Prime
Sophia Taylor #1
C E/2 NE SW 17-18-6
Rice County, Kansas

CONTRACTOR: Prime Drilling Company
COMM: 6-10-54
COMP: 6-20-54

FORMATION

REMARKS

Surface Clay & Rock	20
Shale	85
Sand	110
Shale	145
Shale & Shells	220
Red Bed & Shale	450
Shale & Shells	785
Lime & Shale	1105
Shale & Lime	1120
Sandy Lime & Shale	2825
Shale & Lime	2915
Lime	3030
Lime & Shale	3315
Lime	3375
Cherty Lime	3499
Total Depth	3499

Ran 7 joints 8-5/8" 24# Casing @ 145'
cemented with 100 sax posmix 2% CC.

We certify that the above log is true
and correct to the best of our knowledge
and ability.

PRIME DRILLING COMPANY

By R. R. McNeal

PLUGGING
 FILE SEC 17-18-6 R SW
 BOOK PAGE 42 LINE 21