

STATE OF KANSAS
STATE CORPORATION COMMISSION

Form CP-4


WELL PLUGGING RECORD

Give All Information Completely
Make Required Affidavit
Mail or Deliver Report to:
Conservation Division
State Corporation Commission
212 No. Market
Wichita, Kansas

Reno County, Sec. 30 Twp. 24 Rge. 4 (E)X (W)

Location as "NE/CNW/SW" or footage from lines C NW NE
Lease Owner W. R. Allam
Lease Name Mueller Well No. 1
Office Address Box 92, Haven, Kansas
Character of Well (completed as Oil, Gas or Dry Hole) oil well
Date well completed 12-21-64 19
Application for plugging filed 12-7-65 19
Application for plugging approved 12-9-65 19
Plugging commenced 12-16-65 19
Plugging completed 12-22-65 19
Reason for abandonment of well or producing formation depleted

NORTH

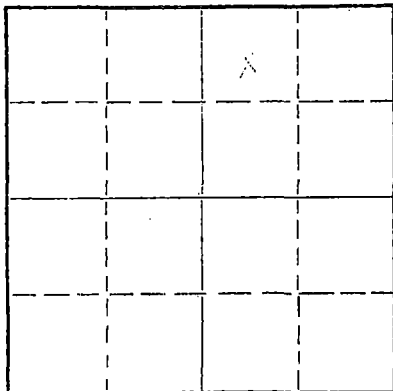

Locate well correctly on above Section Plat

If a producing well is abandoned, date of last production 19
Was permission obtained from the Conservation Division or its agents before plugging was commenced? yes

Name of Conservation Agent who supervised plugging of this well Gilbert Toman
Producing formation Depth to top Bottom Total Depth of Well 3698 Feet
Show depth and thickness of all water, oil and gas formations.

OIL, GAS OR WATER RECORDS

CASING RECORD

FORMATION	CONTENT	FROM	TO	SIZE	PUT IN	PULLED OUT
				12	312	none
				5 1/2	3698	2520

Describe in detail the manner in which the well was plugged, indicating where the mud fluid was placed and the method or methods used in introducing it into the hole. If cement or other plugs were used, state the character of same and depth placed, from feet to feet for each plug set.

Set rock bridge from 312' to 300' and dump 30 sacks cement.
Mud hole to 35', rock bridge to 25' and dump 15 sacks cement.

RECEIVED
STATE CORPORATION COMMISSION

RECEIVED
STATE CORPORATION COMMISSION

JAN 11 1966

JAN 5 1966

1-11-1966

CONSERVATION DIVISION
Wichita, Kansas

(If additional description is necessary, use BACK of this sheet)

Name of Plugging Contractor Flint Engineering & Construction Company
Address Box 950, El Dorado, Kansas

STATE OF KANSAS, COUNTY OF BUTLER, ss.

(employee of owner) or (owner or operator) of the above-described well, being first duly sworn on oath, says: That I have knowledge of the facts, statements, and matters herein contained and the log of the above-described well as filed and that the same are true and correct. So help me God.

(Signature) [Signature]
El Dorado, Kansas
(Address)

SUBSCRIBED AND SWORN TO before me this 29th day of December, 19 65

My commission expires 9-27-67

[Signature]
Notary Public.