


STATE OF KANSAS
STATE CORPORATION COMMISSION

Give All Information Completely
Make Required Affidavit
Mail or Deliver Report to:
Conservation Division
State Corporation Commission
800 Bittling Building
Wichita, Kansas

WELL PLUGGING RECORD

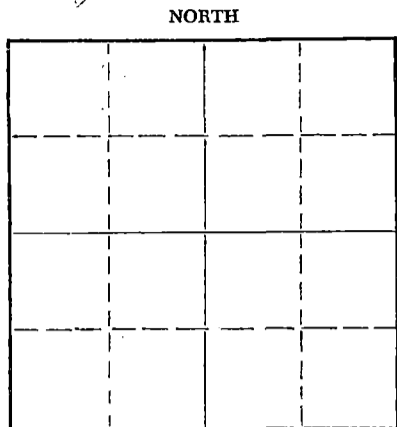

Locate well correctly on above
Section Plat

Rice County, Sec. 26 Twp. 18S Rge. 7W (E) (W)
Location as "NE/CNW/SW" or footage from lines NW of NE
Lease Owner George R Hess et al
Lease Name O'Hara Well No. 1
Office Address Box 188 McPherson, Kansas
Character of Well (completed as Oil, Gas or Dry Hole) Dry Hole
Date well completed Mar 5 1956
Application for plugging filed March 10 1956
Application for plugging approved March 10 1956
Plugging commenced March 10 1956
Plugging completed March 24 1956
Reason for abandonment of well or producing formation Dry

If a producing well is abandoned, date of last production _____ 19____
Was permission obtained from the Conservation Division or its agents before plugging was commenced? Yes

Name of Conservation Agent who supervised plugging of this well Ruel Durkee
Producing formation Cong. Sand Depth to top 3192 Bottom 3198 Total Depth of Well 3229 Feet
Show depth and thickness of all water, oil and gas formations.

OIL, GAS OR WATER RECORDS

CASING RECORD

FORMATION	CONTENT	FROM	TO	SIZE	PUT IN	PULLED OUT
<u>Soil & Clay</u>	<u>0</u>	<u>0</u>	<u>160</u>	<u>8 1/2</u>	<u>160</u>	<u>None</u>
<u>Cong. Sand</u>	<u>Show oil & Water</u>	<u>3192</u>	<u>3198</u>	<u>5 1/2</u>	<u>3198</u>	<u>2783</u>

Describe in detail the manner in which the well was plugged, indicating where the mud fluid was placed and the method or methods used in introducing it into the hole. If cement or other plugs were used, state the character of same and depth placed, from _____ feet to _____ feet for each plug set.

Filled back to 3180' with chat. Dumped 6 sacks of cement. Shot pipe off at 2803'. Pulled pipe and mudded hole to 150'. Set rock bridge and dumped 15 sacks of cement. Mudded hole from 150'. Dumped 5 sacks of cement in top of surface.

Name of Plugging Contractor Bert Self (If additional description is necessary, use BACK of this sheet)
Address RT #4, Hutchinson, Kansas

STATE OF Kans. Reno COUNTY OF _____, ss.


(employee of owner) or (owner or operator) of the above-described well, being first duly sworn on oath, says: That I have knowledge of the facts, statements, and matters herein contained and the log of the above-described well as filed and that the same are true and correct. So help me God.

(Signature) Bert Self
R. R. #4, Hutchinson, Kans.
(Address)

SUBSCRIBED AND SWORN to before me this 26th day of March, 1956

My commission expires August 12, 1957

Norothy Self Notary Public.
George R Hess owner

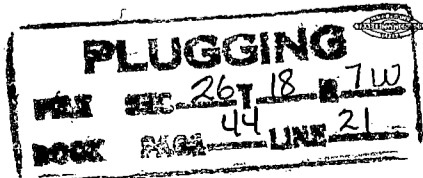

COMPANY: George Hess
 CONTRACTOR: Mallard Drilling Company
 FARM: O'Hara #1
 LOCATION: NW NW NE Sec. 26-18S-7W
 Rice County, Kansas
 COMMENCED: February 20, 1956
 COMPLETED: February 27, 1956

0	to	157	Shale
157	to	715	Shale
715	to	1070	Shale and lime
1070	to	1325	Lime and shale
1325	to	1485	Lime
1485	to	1755	Lime and shale
1755	to	2350	Lime and shale
2350	to	2565	Lime
2565	to	2713	Lime and shale
2713	to	2785	Lime
2785	to	2915	Lime and shale
2915	to	3005	Lime
3005	to	3145	Lime
3145	to	3194	Lime and shale
3194	to	3199	Conglomerate and sand
		3199	T.D. Rotary

Set 157 feet of 8 5/8" surface pipe. Cemented with 100 sacks cement.

Set 5 1/2" at 3196. Cemented with 40 sacks cement, 10 in rat hole

TOPS: Conglomerate -- 3191 Pinn sand -- 3196

Measurements taken from R.D.B. R.D.B. 4-5 1/2' from ground level.

C E R T I F I C A T E

I, C. C. Nelson, do hereby certify that the above and foregoing is a true and correct copy of log of the O'Hara #1, Rice County, Kansas, as reflected by files of the Mallard Drilling Company.

C. C. Nelson

Subscribed and sworn to before me a Notary Public, within and for Sedgwick County, Kansas, this 28th day of February 1956.

Robert G. Harsh

My commission expires 11-16-59

D.D. 3229. *white* Shale
 P.B. 3202. *Referto* 3191-96.
 3ho oil & water
 and frak 2500 gal - 2500⁰tt
 Frak test 1 1/2 hr 10 gal oil 2 BW
 1 1/2 hr test

RECEIVED
 STATE DEPT
 MAR 27 1956

PLUGGING
 SEC 26 T 18 R 7W
 BOX 44 LINE 21