


STATE OF KANSAS
STATE CORPORATION COMMISSION

Form CP-4

Give All Information Completely
Make Required Affidavit
Mail or Deliver Report to:
Conservation Division
State Corporation Commission

WELL PLUGGING RECORD

P. O. Box 17027
Wichita, Kansas 67217
NORTH

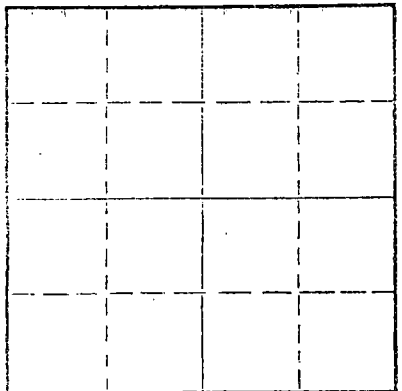

Locate well correctly on above
Section Plat

Rice County. Sec. 26 Twp. 18S Rge. 7W (E) (W) X
Location as "NE/CNWSW" or footage from lines SE NE SE
Lease Owner Halliburton Oil Producing Co.
Lease Name Coldsnow Well No. 1
Office Address 117 Cameron Bldg., 2915 Classen Blvd., Okla. City, Okla.
Character of Well (completed as Oil, Gas or Dry Hole) D & A
Date well completed July 17 19 73
Application for plugging filed July 17 19 73
Application for plugging approved July 17 19 73
Plugging commenced July 17 19 73
Plugging completed July 17 19 73
Reason for abandonment of well or producing formation D & A

If a producing well is abandoned, date of last production 19
Was permission obtained from the Conservation Division or its agents before plugging was commenced? Yes

Name of Conservation Agent who supervised plugging of this well Gilbert Toman
Producing formation Depth to top Bottom Total Depth of Well 3,295' Feet
Show depth and thickness of all water, oil and gas formations.

OIL, GAS OR WATER RECORDS

CASING RECORD

FORMATION	CONTENT	FROM	TO	SIZE	PUT IN	PULLED OUT
				8-5/8"	206'	-0-

Describe in detail the manner in which the well was plugged, indicating where the mud fluid was placed and the method or methods used in introducing it into the hole. If cement or other plugs were used, state the character of same and depth placed, from feet to feet for each plug set.

Plugged @ 225' w/25 sx.
Plugged @ 40' w/10 sx.

RECEIVED
STATE CORPORATION COMMISSION
JUL 30 1973
7-30-1973
CONSERVATION DIVISION
Wichita, Kansas


(If additional description is necessary, use BACK of this sheet)
Name of Plugging Contractor Red Tiger Drilling Company
Address 1720 Wichita Plaza, Wichita, Kansas 67202

STATE OF Kansas COUNTY OF Sedgwick, ss.
Linda H. Dickens (employee of owner) or (owner or operator) of the above-described

well, being first duly sworn on oath, says: That I have knowledge of the facts, statements, and matters herein contained and the log of the above-described well as filed and that the same are true and correct. So help me God.

(Signature) Linda H. Dickens
1720 Wichita Plaza, Wichita, Kansas 67202
(Address)

Subscribed and sworn to before me this 25th day of July, 19 73

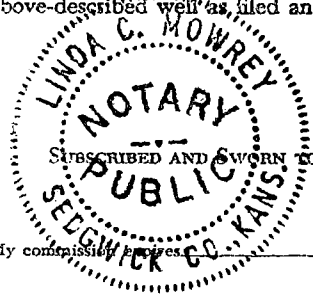

Linda C. Mowrey
Notary Public.

My commission expires May 24, 1977

DRILLERS LOG

No. 1 Coldsnow

CASING RECORD: 8-5/8" @ 206' w/150 sx cement
 COMPANY: Halliburton Oil Producing Co.
 CONTRACTOR: Red Tiger Drilling Company
 COMMENCED: July 9, 1973
 COMPLETED: July 17, 1973
 TOTAL DEPTH: 3,295'
 DESCRIPTION: SE NE SE 26-18S-7W Rice County, Kansas
 ELEVATION:

<u>FORMATION</u>	<u>FROM</u>	<u>TO</u>	<u>REMARKS</u>
Clay & Post Rock	0	105	
Shale	105	170	
Hard Rock & Shale	170	209	
Shale & Sand Streaks	209	955	
Shale & Lime	955	2325	
Lime	2325	2420	
Lime & Shale	2420	2713	
Lime	2713	3295	

RECEIVED
 STATE CORPORATION COMMISSION
 JUL 30 1973
 CONSERVATION DIVISION
 Wichita, Kansas

I certify that this is a true and correct copy of the above log to the best of my knowledge.

RED TIGER DRILLING COMPANY

Linda H. Dickens
 Linda H. Dickens

Subscribed and sworn to before me this 25th day of July, 1973.

Linda C. Mowrey
 Notary Public

My Commission Expires:

May 24, 1977

