


15 159-00406.00-00

STATE OF KANSAS
STATE CORPORATION COMMISSION

Give All Information Completely
Make Required Affidavit
Mail or Deliver Report to:
Conservation Division
State Corporation Commission
800 Bittling Building
Wichita, Kansas

WELL PLUGGING RECORD

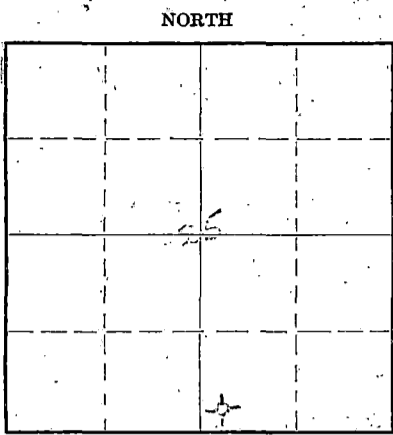

Locate well correctly on above
Section Plat

Rice County. Sec. 25 Twp. 18 Rge. (E) 7 (W)
Location as "NE/CNW 1/4 SW 1/4" or footage from lines C. SW SW SE
Lease Owner Donald T. Ingling, et al
Lease Name Wolf Well No. 1
Office Address 708 Fourth National Bank Bldg, Wichita, Kas
Character of Well (completed as Oil, Gas or Dry Hole) dry hole
Date well completed June 17 1949
Application for plugging filed June 17 1949
Application for plugging approved June 17 1949
Plugging commenced June 17 1949
Plugging completed June 17 1949
Reason for abandonment of well or producing formation dry

If a producing well is abandoned, date of last production none 19
Was permission obtained from the Conservation Division or its agents before plugging was commenced? yes

Name of Conservation Agent who supervised plugging of this well Ruel Durkee
Producing formation none Depth to top Bottom Total Depth of Well 351 1/2 Feet
Show depth and thickness of all water, oil and gas formations.

OIL, GAS OR WATER RECORDS

CASING RECORD

| Formation | Content | From | To | Size | Put In | Pulled Out |
|-----------|---------|------|----|--------|--------|------------|
| | | | | 8-5/8" | 170' | none |
| | | | | | | |
| | | | | | | |
| | | | | | | |
| | | | | | | |

Describe in detail the manner in which the well was plugged, indicating where the mud fluid was placed and the method or methods used in introducing it into the hole. If cement or other plugs were used, state the character of same and depth placed, from _____ feet to _____ feet for each plug set.

gunned pits - laid down half of drill pipe and filled hole with heavy mud and then laid down second half of drill pipe and filled hole with heavy mud - bottom plug @ 170' - 15 sacks cement filled with mud to 25' of top then 5 sacks cement.

RECEIVED

Conservation Div

JUN 20 1949 6-20-1949

STATE CORPORATION
COMMISSION
KANSAS

(If additional description is necessary, use BACK of this sheet)

Correspondence regarding this well should be addressed to Donald T. Ingling
Address 708 Fourth National Bank Building, Wichita, 2, Kansas

STATE OF KANSAS, COUNTY OF SEDGWICK, ss.

M. E. Black (employee of owner) or (owner or operator) of the above-described well, being first duly sworn on oath, says: That I have knowledge of the facts, statements, and matters herein contained and the log of the above-described well as filed and that the same are true and correct. So help me God.

(Signature)

M. E. Black

(Address)

SUBSCRIBED AND SWORN to before me this 17th day of June, 1949


Mary Hanna

Notary Public.

My commission expires

October 22, 1949

22-5133-s 9-48-10M

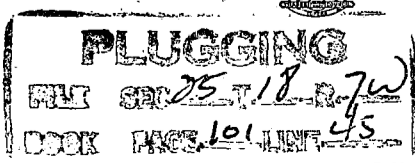

WELL LOG * WOLF NO. 1

Donald T. Ingling, et al, Lease Owner. Section 25-T18-7W
 Donald T. Ingling, Operator. Location: C SW SW SE
 Total Depth: 3514' Elevation: 1644'
 Commenced: May 28, 1949 Production: Dry
 Completed: June 17, 1949
 Casing: 170' of 8-5/8" Rice County, Kas.

Figures below indicate bottom of formation:

| | |
|-------------------------|------------------------------|
| 30 Clay | 2565 Lime |
| 50 Sand | 2680 Shale & Lime |
| 75 Shale & Shells | 2722 Shale |
| 150 Shale | 3158 Lime |
| 170 Shale & Hard Lime | 3195 Congl. - cherty & lime |
| 182 Lime | 3220 Kinderhook shale |
| 460 Shale & Red rock | 3260 Simpson - Shale & Chert |
| 495 Anhydrite | 3285 Shale |
| 660 Shale | 3300 Shale-sandy |
| 875 Salt & Shale | 3328 Sandy - Shale & Chert |
| 970 Lime & Shale | 3345 Lime & Shale- sandy |
| 1100 Lime-sandy streaks | 3380 Viola lime |
| 1310 Lime & Shale | 3398 Simpson Sand |
| 1395 Lime- sandy | 3460 Arbuckle |
| 2320 Lime & Shale | 3514 Total Depth |

I hereby certify that this is a true and correct log of the above mentioned well.

DONALD T. INGLING

STATE OF KANSAS |
 SEDGWICK COUNTY | SS.

RECEIVED
 Conservation Div.

PLUGGING
 FILE SEC 25 T18 R7W

JUN 20 1949

CORPORATION
 COMMISSIONER
 KANSAS

Subscribed to and sworn to before me, a Notary Public in said County and state this 17th Day of June, 1949

Mary Hanna
 Notary Public

My commission expires: October 22, 1949.