

STATE OF KANSAS
STATE CORPORATION COMMISSION

Give All Information Completely
Make Required Affidavit
Mail or Deliver Report to:
Conservation Division
State Corporation Commission
800 Bitting Building
Wichita, Kansas

WELL PLUGGING RECORD

Rice County. Sec. 25 Twp. 18 Rge. 7 (E) W (W)

Location as "NE/CNW/SW" or footage from lines NE NE NE

Lease Owner E. H. Riggs, Etal

Lease Name Sellers Well No. 1

Office Address 701 Union Nat'l Bank Bldg, Wichita, Kansas

Character of Well (completed as Oil, Gas or Dry Hole) Dry Hole

Date well completed 6-6 19 53

Application for plugging filed 6-6 19 53

Application for plugging approved 6-6 19 53


Plugging commenced 6-6 19 53

Plugging completed 6-6 19 53

Reason for abandonment of well or producing formation Dry Hole

If a producing well is abandoned, date of last production 19

Was permission obtained from the Conservation Division or its agents before plugging was commenced? Yes

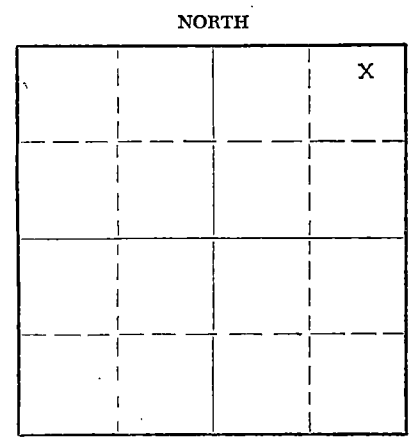

Locate well correctly on above Section Plat

Name of Conservation Agent who supervised plugging of this well Ruall Durkee

Producing formation Depth to top Bottom Total Depth of Well 3515 Feet

Show depth and thickness of all water, oil and gas formations.

OIL, GAS OR WATER RECORDS

CASING RECORD

FORMATION	CONTENT	FROM	TO	SIZE	PUT IN	PULLED OUT
				8 5/8"	260	None

Describe in detail the manner in which the well was plugged, indicating where the mud fluid was placed and the method or methods used in introducing it into the hole. If cement or other plugs were used, state the character of same and depth placed, from feet to feet for each plug set.

Hole was filled with heavy mud to 255' and plug was set and 15 sacks of cement were hand mixed and poured through the drill pipe on top of the plug. Hole was then filled with heavy mud to 20' and 5 sacks of cement were mixed and put on top of plug.

6-11-1953


Name of Plugging Contractor SCHAFER DRILLING COMPANY
Address PEOPLES BANK BUILDING, PRATT, KANSAS

STATE OF Kansas, COUNTY OF Pratt, ss.
J. E. Selby (employee of owner) of the above-described well, being first duly sworn on oath, says: That I have knowledge of the facts, statements, and matters herein contained and the log of the above-described well as filed and that the same are true and correct. So help me God.

(Signature) J. E. Selby
Peoples Bank Building, Pratt, Kansas (Address)

SUBSCRIBED AND SWORN TO before me this 10th day of June, 19 53

My commission expires February 25, 1956
Hilda Coulter Notary Public.

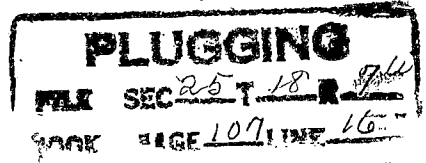

DRILLING LOG
SELLERS # 1

0-171	Top Soil and Shale
171-220	Red Bed
220-250	Anhydrite & Shale
250-305	Red Bed
305-920	Shale
920-1130	Shale & Lime
1130-1280	Shale & Shells
1280-1465	Lime
1465-1815	Broken Lime & Shale
1815-2200	Shale & Lime
2200-2290	Shale
2290-2395	Shale & Lime
2395-2420	Shale
2420-2525	Lime
2525-2680	Shale & Lime
2680-3041	Lime
3041-3180	Shale & Lime
3180-3240	Shale
3240-3342	Shale & Sand
3342-3362	Chert
3362-3408	Shale & Lime
3408-3448	Shale & Sand
3448-3495	Shale-Sand & Lime
3495-3515	Arbuckle
3515	TOTAL DEPTH

RECEIVED
 JUN 25 11 14 AM '74
 107 16

RECEIVED
 JUN 1 1974
 CONSERVATION DIVISION
