


STATE OF KANSAS
STATE CORPORATION COMMISSION

Give All Information Completely
Make Required Affidavit
Mail or Deliver Report to:
Conservation Division
State Corporation Commission
800 Bitting Building
Wichita, Kansas

WELL PLUGGING RECORD

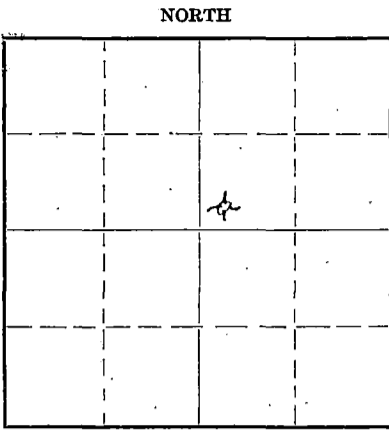

Locate well correctly on above
Section Plat

Rice County. Sec. 21 Twp. 18 Rge. 7 (E) (W)
Location as "NE/CNW 1/4 SW 1/4" or footage from lines SW SW NE
Lease Owner Heathman Drilling Company
Lease Name Well Well No. 1
Office Address Orpheum Building
Character of Well (completed as Oil, Gas or Dry Hole) Dry
Date well completed December 2 19 49
Application for plugging filed " 19 49
Application for plugging approved " 19 49
Plugging commenced " 19 49
Plugging completed " 19 49
Reason for abandonment of well or producing formation

If a producing well is abandoned, date of last production 19
Was permission obtained from the Conservation Division or its agents before plugging was commenced? yes

Name of Conservation Agent who supervised plugging of this well
Producing formation Depth to top Bottom Total Depth of Well 3116 Feet
Show depth and thickness of all water, oil and gas formations.

OIL, GAS OR WATER RECORDS

CASING RECORD

Formation	Content	From	To	Size	Put In	Pulled Out
				3 5/8	188	none

Describe in detail the manner in which the well was plugged, indicating where the mud fluid was placed and the method or methods used in introducing it into the hole. If cement or other plugs were used, state the character of same and depth placed, from feet to feet for each plug set.

Filled hole full heavy mud to within 188 feet, drove wooden plug
to 188 feet, dumped in 15 sacks cement, finished filling hole
full heavy mud to within 15 feet of cellar, and put in five
sacks cement.

RECORDED 12-9-1949
DEC 7 - 1949

(If additional description is necessary, use BACK of this sheet)

Correspondence regarding this well should be addressed to Heathman Drilling Company
Address Orpheum Building, Wichita, Kansas

STATE OF Kansas, COUNTY OF Sedgwick, ss.
G. C. Nelson, partner, Mallard Drg. Co. (employee of owner) or (owner or operator) of the above-described well,
being first duly sworn on oath, says: That I have knowledge of the facts, statements, and matters herein contained and the log of the above-described well as filed and that the same are true and correct. So help me God.

(Signature) G. C. Nelson

(Address)

SUBSCRIBED AND SWORN to before me this 6th day of Dec 1949

Raywell Wright
Notary Public.

My commission expires 12/4/52

PLUGGING
FILE SEC 21 T 18 R 7 W
DATE MAR 18 1950

COMPANY: Heathman Drilling Company
 CONTRACTOR: Mallard Drilling Company
 WELL: Well #1
 LOCATION: SW SW NE Sec. 21-18-7W
 Rice County, Kansas
 COMMENCED: November 23, 1949
 COMPLETED: December 2, 1949

0	to	188	Shale
188	to	280	Shale and shells
280	to	830	Shale and shells
830	to	935	Salt and shells
935	to	990	Shale
990	to	1030	Anhydrite
1030	to	1150	Shale and lime
1150	to	1900	Lime
1900	to	2410	Shale and lime
2410	to	2735	Lime
2735	to	2820	Shale and lime
2820	to	3115	Lime
3115	to	3180	Lime and sand
3180	to	3255	Lime and shale
3255	to	3305	Lime
3305	to	3385	Lime
3385	to	3416	Shale
3416	to	3446	Lime
		3446	T.D. Rotary

Set 188 feet of 8 5/8" surface pipe. Cemented with 135 sacks cement.

TOPS: R.C. 2759 Simpson 3383 Viola 3312
 Arbuckle 3416

Measurements taken from derrick floor

DRY, ABANDONED AND PLUGGED

C E R T I F I C A T E

I, G. C. Nelson, do hereby certify that the above and foregoing is a true and correct copy of log of the Well #1, Section 21-18-7W, Rice County, Kansas, as reflected by files of the Mallard Drilling Company.

G. C. Nelson

Subscribed and sworn to before me a notary public, within and for Sedgwick County, Kansas, this 6th day of December 1949.

My commission expires 12/4/52

Raymond Wright

PLUGGING
 WELL SEC 21-18-7W
 DECK FACE 128
 89

RECEIVED
 Conservation Div.
 DEC 7 - 1949
 STATE CONSERVATION
 CO. KANSAS