

STATE OF KANSAS
STATE CORPORATION COMMISSION


Form CP-4

Give All Information Completely
Make Required Affidavit
Mail or Deliver Report to:
Conservation Division
State Corporation Commission
211 No. Broadway
Wichita, Kansas

WELL PLUGGING RECORD

Rice County. Sec. 21 Twp. 18 Rge. 7 (E) W (W)
Location as "NE/CNW $\frac{1}{2}$ SW $\frac{1}{4}$ " or footage from lines C of SE SE

Lease Owner George Reed
Lease Name Williams Well No. 1
Office Address 1301 Union National Building Wichita, Kansas
Character of Well (completed as Oil, Gas or Dry Hole) D & A
Date well completed 5-16-66 19
Application for plugging filed 5-16-66 19
Application for plugging approved 5-16-66 19
Plugging commenced 5-16-66 19
Plugging completed 5-16-66 19
Reason for abandonment of well or producing formation _____

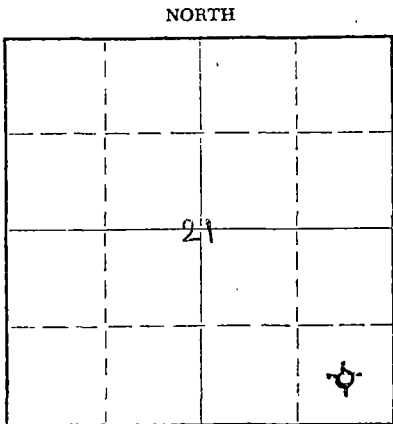

Locate well correctly on above Section Plat

If a producing well is abandoned, date of last production _____ 19
Was permission obtained from the Conservation Division or its agents before plugging was commenced? Yes

Name of Conservation Agent who supervised plugging of this well Gilbert Toman
Producing formation _____ Depth to top _____ Bottom _____ Total Depth of Well 3472' Feet
Show depth and thickness of all water, oil and gas formations.

OIL, GAS OR WATER RECORDS

CASING RECORD

FORMATION	CONTENT	FROM	TO	SIZE	PUT IN	PULLED OUT
				8-5/8"	252'	None

Describe in detail the manner in which the well was plugged, indicating where the mud fluid was placed and the method or methods used in introducing it into the hole. If cement or other plugs were used, state the character of same and depth placed, from _____ feet to _____ feet for each plug set.

Set bottom plug at 240' w/1/4 sxs hulls and 20 sxs cement. Set plug at 40' w/1/2 sx hulls and 10 sxs cement. 2 sxs cement in rat hole.

RECEIVED
STATE CORPORATION COMMISSION

MAY 26 1966

5-26-1966
CONSERVATION DIVISION
Wichita, Kansas

(If additional description is necessary, use BACK of this sheet)
Name of Plugging Contractor Glickman Oil Company
Address 702 S. St. Francis, Wichita, Kansas

STATE OF Kansas, COUNTY OF Sedgwick, ss.
Milton Glickman (employee of owner) or (owner or operator) of the above-described well, being first duly sworn on oath, says: That I have knowledge of the facts, statements, and matters herein contained and the log of the above-described well as filed and that the same are true and correct. So help me God.

(Signature) Milton Glickman
702 S. St. Francis, Wichita, Kansas
(Address)

SUBSCRIBED AND SWORN TO before me this 24th day of May 19 66

My commission expires Nov. 19, 1967

Lorella Schauf
Lorella Schauf
Notary Public.

GLICKMAN OIL COMPANY

P.O. Box 3104 11104

Wichita, Kansas 67211 67202

COPY

DRILLERS WELL LOG

Company: George Reed Location: C of SE SE
 Farm: Williams Well No. 1 21-18S-7W
 Rice County, Kansas
 Commenced: May 7, 1966 Elevation: 1681' KB
 Completed: May 16, 1966 Geologist: George Reed
 Total Depth: 3472'
 Casing: 8-5/8" @ 252' w/170 sxs Production: D & A

Figures Indicate Bottom of Formations

		TOPS	
252'	Shale, Sand & Post Rock	Heebner	2610' -929'
360'	Shale Red Bed	Brown Lime	2741' -1060'
800'	Red Bed & Shale	Lansing	2778' -1097'
978'	Salt Sections & Shale	Congl.	3189' -1508'
1005'	Anhydrite	Viola	3226' -1545'
1520'	Shale & Lime	Simpson	3369' -1888'
1730'	Cherty Lime	Arbuckle	3430' -1749'
1750'	Shale		
2290'	Shale & Lime		
2376'	Lime & Shale		
2445'	Lime		
2610'	Lime & Shale		
2615'	Shale (HB)		
2640'	Lime & Shale		
2713	Shale		
2810'	Lime & Chert		
2830'	Lime, Chert & Shale		
2950'	Lime & Shale		
3154'	Lime		
3210'	Shaly Lime		
3370'	Lime & Shale		
3418'	Sandy Shale & Lime		
3450'	Lime & Sand		
3472'	Lime		
3472'	T.D.		

STATE OF KANSAS, COUNTY OF SEDGWICK, ss:

I, Milton Glickman, of the Glickman Oil Company, upon oath state that the above and foregoing is a true and correct copy of the log of the Williams #1 Glickman Oil Company

Milton Glickman

Subscribed and sworn to before me this 24th day of May, 1966.

Lorella Schauf, Notary Public

My Commission Expires: Nov. 19, 1967

RECEIVED STATE CORPORATION COMMISSION

MAY 26 1966

CONSERVATION DIVISION Wichita, Kansas