


STATE OF KANSAS
STATE CORPORATION COMMISSION

WELL PLUGGING RECORD

Give All Information Completely
Make Required Affidavit
Mail or Deliver Report to:
Conservation Division
State Corporation Commission
800 Bittig Building
Wichita, Kansas

Rice County. Sec. 13 Twp. 18 Rge. 7 (E) W (W)
Location as "NE/CNW/SW" or footage from lines SW-SW-NE
Lease Owner E. H. RIGGS
Lease Name Bronleeve Well No. 1
Office Address 408 Rule Bldg., Wichita, Kansas
Character of Well (completed as Oil, Gas or Dry Hole) Dry Hole
Date well completed July 30, 19 54
Application for plugging filed September 13, 19 54
Application for plugging approved September 16, 19 54
Plugging commenced September 18, 19 54
Plugging completed September 23, 19 54
Reason for abandonment of well or producing formation Dry Hole

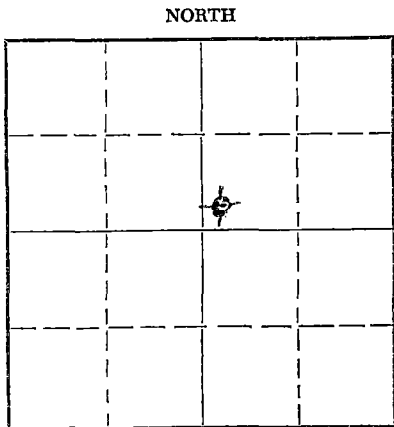

Locate well correctly on above
Section Flat

If a producing well is abandoned, date of last production 19
Was permission obtained from the Conservation Division or its agents before plugging was commenced? Yes

Name of Conservation Agent who supervised plugging of this well Durkee
Producing formation Depth to top Bottom Total Depth of Well 3390' Feet
Show depth and thickness of all water, oil and gas formations.

OIL, GAS OR WATER RECORDS

CASING RECORD

FORMATION	CONTENT	FROM	TO	SIZE	PUT IN	PULLED OUT
				8-5/8	214'	None
				5 1/2	3314'	2824'

Describe in detail the manner in which the well was plugged, indicating where the mud fluid was placed and the method or methods used in introducing it into the hole. If cement or other plugs were used, state the character of same and depth placed, from feet to feet for each plug set.

Mud to 210', set rock bridge, dumped 15 sacks mud to 20', set rock bridge
5 sacks cement, cap well

(If additional description is necessary, use BACK of this sheet)
Name of Plugging Contractor Forbes Casing Pulling Company
Address Great Bend, Kansas

STATE OF KANSAS, COUNTY OF SEDGWICK, ss.
E. H. Riggs (employee of owner) or (owner or operator) of the above-described well, being first duly sworn on oath, says: That I have knowledge of the facts, statements, and matters herein contained and the log of the above-described well as filed and that the same are true and correct. So help me God.

(Signature) E. H. Riggs
(Address)

SUBSCRIBED AND SWORN TO before me this 27th day of September, 1954

My commission expires March 3, 1958
Leva L. Murray Notary Public.

24-7368-S 3-53-20M

PLUGGING
FILED SEC 13 T 18 R 7W
BOOK PAGE 64 LINE 24

10-20-1954