


STATE OF KANSAS
STATE CORPORATION COMMISSION

WELL PLUGGING RECORD

Give All Information Completely
Make Required Affidavit
Mail or Deliver Report to:
Conservation Division
State Corporation Commission
800 Bittling Building
Wichita, Kansas

Rice County. Sec. 13 Twp. 18 Rge. 7 (W)

NORTH

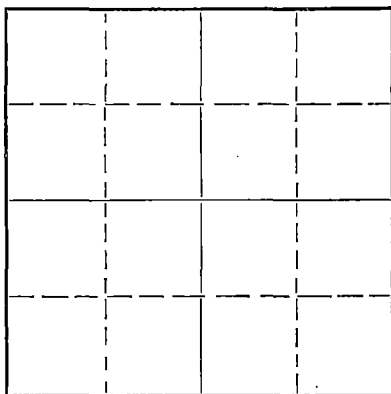

Locate well correctly on above
Section Plat

Location as "NE/CNW $\frac{1}{4}$ /SW $\frac{1}{4}$ " or footage from lines SW SW NE
Lease Owner J. R. Greeley Drilling Co., et al
Lease Name Bronleewe Well No. 1
Office Address 208 East Waterman, Wichita, Kansas
Character of Well (completed as Oil, Gas or Dry Hole) Dry Hole
Date well completed July 6, 1952
Application for plugging filed July 7, 1952
Application for plugging approved July 7, 1952
Plugging commenced July 7, 1952
Plugging completed July 7, 1952
Reason for abandonment of well or producing formation Dry Hole

If a producing well is abandoned, date of last production 19...
Was permission obtained from the Conservation Division or its agents before plugging was commenced? Yes

Name of Conservation Agent who supervised plugging of this well Ruel Durkee
Producing formation..... Depth to top..... Bottom..... Total Depth of Well 3494 Feet
Show depth and thickness of all water, oil and gas formations.

OIL, GAS OR WATER RECORDS

CASING RECORD

Formation	Content	From	To	Size	Put In	Pulled Out
Shale & Shells, Sand, Shale, Shale & Shells		0'	219'	8 5/8"	220'	None

Describe in detail the manner in which the well was plugged, indicating where the mud fluid was placed and the method or methods used in introducing it into the hole. If cement or other plugs were used, state the character of same and depth placed, from.....feet to.....feet for each plug set.

Bottom plug set at 210' Sun plug & two hull plugs, 15 ex cement through drill pipe. Top plug set @ 20', 5 ex cement.

RECEIVED
STATE CORPORATION COMMISSION
7-10-1952
CONSERVATION DIVISION
KANSAS

(If additional description is necessary, use BACK of this sheet)

Name of Plugging Contractor J. R. Greeley Drilling Co.
Address 208 East Waterman, Wichita, Kansas


STATE OF Kansas, COUNTY OF Sedgwick, ss.
I, J. R. Greeley, Operator (employee of owner) or (owner or operator) of the above-described well, being first duly sworn on oath, says: That I have knowledge of the facts, statements, and matters herein contained and the log of the above-described well as filed and that the same are true and correct. So help me God.

(Signature) J. R. Greeley
208 East Waterman, Wichita, Kansas (Address)

SUBSCRIBED AND SWORN to before me this 9th day of July, 1952
Luille Betz Notary Public.

My commission expires December 7, 1953

23-8390-s

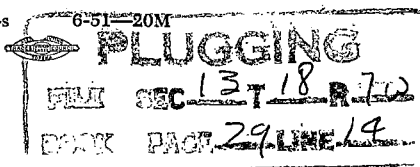

DRILLER'S LOG

J. R. Greeley Drilling Co., et al
Bronleewe No. 1

Location: SW SW NE
Sec. 13-18-7W
Rice County, Kansas

Contractor: J. R. Greeley Drilling Co.

Comm. Drl'g: 6-21-52

Comm. Drl'g: 7- 8-52

Total Depth: 3494'

Casing: 218' 8 5/8"

Production: D & A

FIGURES INDICATE BOTTOM OF FORMATION

155'	Shale & Shells
175'	Sand
195'	Shale
219'	Shale & Shells
425'	Shale, Shells & Redbed
550'	Shells & Shale
530'	Anhydrite
775'	Shale & Shells
330'	Salt
1040'	Lime & Shale
1190'	Shale & Shells
1525'	Lime & Shale
1615'	Lime
1870'	Lime & Shale
2065'	Shale & Shells
2125'	Lime
2160'	Shale & Lime
2230'	Bro. Lime & Shale
2525'	Lime & Shale
2585'	Lime
2751'	Lime & Shale
3190'	Lime
3239'	Lime & Shale
3244'	Sand
3305'	Sand & Shale
3490'	Lime
3494'	T.D.R.B.

RECEIVED
STATE COMMISSION

JUL 1 1952

CONSERVATION COMMISSION
Wichita, Kansas

PLUGGING

FILE SEC 13-18-7W

BOOK PAGE 29 LINE 14

STATE OF KANSAS)
) SS
COUNTY OF SEDGWICK)

I, J. R. GREELEY, d/b/a J. R. GREELEY
DRILLING COMPANY, being duly sworn on oath state
that the attached is a true and correct log taken from
the Daily Drilling Reports on the Bronlaewe No. 1, located
Southwest (SW) Southwest (SW) Northeast (NE) Section 13,
Township 13, Range 7W, Rice County, Kansas.

J. R. Greeley Owner
J. R. Greeley Drilling Co.
208 East Waterman
Wichita, Kansas

Subscribed and sworn to before me this 9th day
of July, 1952.

Lucille Burton
Notary Public

My commission expires:

December 7, 1953

PLUGGING
FILE SEC I R
BOOK PAGE --- LINE ---