


STATE OF KANSAS
STATE CORPORATION COMMISSION

WELL PLUGGING RECORD

Give All Information Completely
Make Required Affidavit
Mail or Deliver Report to:
Conservation Division
State Corporation Commission
211 No. Broadway
Wichita, Kansas

Rice County. Sec. 13 Twp. 18S Rge. 7W (E) (W)

T 18S NORTH R 7W

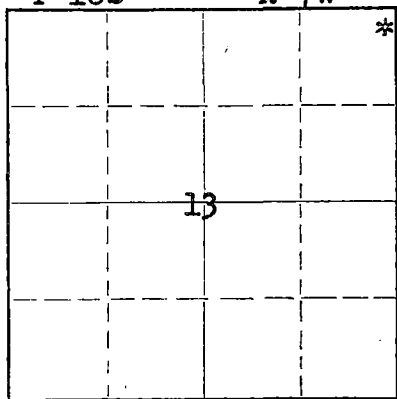

Locate well correctly on above Section Plat

Location as "NE/CNW*SW*" or footage from lines. NE NE NE
Lease Owner Time Petroleum Company
Lease Name Bronleewe Well No. 1
Office Address 512 Orpheum Building - Wichita, Kansas
Character of Well (completed as Oil, Gas or Dry Hole) _____
Date well completed _____ 19____
Application for plugging filed _____ 19____
Application for plugging approved _____ 19____
Plugging commenced October 8 19 56
Plugging completed October 10 19 56
Reason for abandonment of well or producing formation _____

If a producing well is abandoned, date of last production _____ 19____
Was permission obtained from the Conservation Division or its agents before plugging was commenced? Yes

Name of Conservation Agent who supervised plugging of this well Ruel Durkee
Producing formation _____ Depth to top _____ Bottom _____ Total Depth of Well 3270 Feet
Show depth and thickness of all water, oil and gas formations.

OIL, GAS OR WATER RECORDS

CASING RECORD

FORMATION	CONTENT	FROM	TO	SIZE	PUT IN	PULLED OUT
				8-5/8"	210'	None
				5-1/2"	3270'	2659'
				Casing perforated from 3175' to 3180'.		

Describe in detail the manner in which the well was plugged, indicating where the mud fluid was placed and the method or methods used in introducing it into the hole. If cement or other plugs were used, state the character of same and depth placed, from _____ feet to _____ feet for each plug set.

Filled the hole with sand from 3270' to 3165' and ran 6 sacks of cement. Mudded the hole to 210', set a 10' rock bridge and ran 15 sacks of cement which filled to 148'. Mudded the hole to 25', set a rock bridge to 17' and ran 5 sacks of cement to fill to base of cellar. Plugging completed.

RECEIVED
STATE CORPORATION COMMISSION
OCT 26 1956
CONSERVATION DIVISION
WICHITA, KANSAS

10-26-1986

(If additional description is necessary, use BACK of this sheet)
Name of Plugging Contractor West Supply Co., Inc.
Address Chase, Kansas

STATE OF Kansas, COUNTY OF Sedgewick, ss.
R. J. Schreiner (employee of owner) or (~~owner or operator~~) of the above-described well, being first duly sworn on oath, says: That I have knowledge of the facts, statements, and matters herein contained and the log of the above-described well as filed and that the same are true and correct. So help me God.

(Signature) R. J. Schreiner
512 Orpheum Bldg (Address)

SUBSCRIBED AND SWORN to before me this 25 day of October, 1956

Barbara Oldfield
Notary Public.

My commission expires 10-29-56

PLUGGING
FILE SEC 13 T 18 R 7W
BOOK PAGE 98 LINE 12

ROTARY DRILLING LOG

OPERATOR: E. H. Riggs
Bronkswe #1
NE NE NE Sec. 13-18S-7W
Rice County, Kansas

CONTRACTOR: Prime Drilling Company
COMM: 3-12-54
COMP: 3-23-54

FORMATION

REMARKS

Clay & Surface Rock	40
Sand	60
Shale	90
Shale & Shells	208
Lime	220
Shale W/Shells	245
Red Rock	390
Red Rock & Shells	440
Shale & Shells	935
Shale & Shell	1015
Sand	1350
Lime W Shale Breaks	1465
Shale & Lime	1745
Shale W/Lime Streaks	1990
Shale & Lime	2245
Shale W/Lime Streaks	2280
Lime W/Shale Breaks	2315
Lime & Shale	2340
Lime W/Shale Breaks	2402
Lime & Shale	2435
Lime W/Shale Breaks	2495
Lime & Shale	2570
Lime W/Shale Breaks	2610
Shale W/Lime Streaks	2725
Lime & Shale	2805
Lime W/Shale Breaks	2915
Shale W/Lime	2960
Lime	3030
Lime & Shale	3140
Shale & Sand	3176
Shale & Sand	3270
Total Depth	3270

Run 10 joints of 8-5/8" casing; set at 210', cemented with 125 sax Portland 2% CC.

Run 104 joints 5-1/2" 11" J-55; set @ 3270'; cemented with 75 sax pozmix.

We certify that the above log is true and correct to the best of our knowledge and belief.

PRIME DRILLING COMPANY

BY R.R. McNeel

PLUGGING
FILE SEC. 13 T. 18 R. 7W
BOOK PAGE 98 LINE 12

RECEIVED
STATE CORPORATION COMMISSION
OCT 15 1955
CONSERVATION DIVISION
Wichita, Kansas