

STATE OF KANSAS
STATE CORPORATION COMMISSION

WELL PLUGGING RECORD

Give All Information Completely
Make Required Affidavit
Mail or Deliver Report to
Conservation Division
State Corporation Comm.
245 North Water
Wichita, KS 67202

Rice County. Sec. 13 Twp. 18 Rge. 7W E/W
Location as "NE/CNW $\frac{1}{4}$ SW $\frac{1}{4}$ " or footage from lines
SW NW NW


Lease Owner R & B Petroleum, Inc.
Lease Name DEEDS "C" Well No. 1
Office Address 250 Park Avenue, New York, NY 10017
Character of Well (Completed as Oil, Gas or Dry Hole)
Dry Hole

Date Well completed 6/29 1981
Application for plugging filed 6/29 1981
Application for plugging approved 6/29 1981
Plugging commenced 6/29 1981
Plugging completed 6/29 1981
Reason for abandonment of well or producing formation
Dry Hole

If a producing well is abandoned, date of last production
19

Was permission obtained from the Conservation Division or
its agents before plugging was commenced? yes

Name of Conservation Agent who supervised plugging of this well Duane Rankin
Producing formation Depth to top Bottom Total Depth of Well 3262'
Show depth and thickness of all water, oil and gas formations.

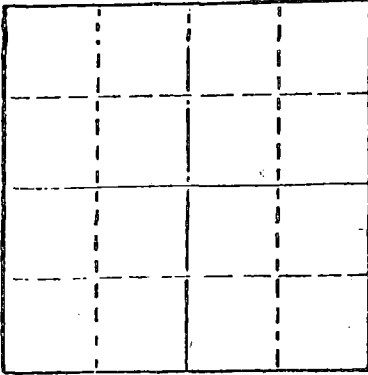

Locate well correctly on above
Section Plot

OIL, GAS OR WATER RECORDS

CASING RECORD

FORMATION	CONTENT	FROM	TO	SIZE	PUT IN	PULLED OUT
		0	205'	8-5/8"	205'	none

Describe in detail the manner in which the well was plugged, indicating where the mud fluid
was placed and the method or methods used in introducing it into the hold. If cement or other
plugs were used, state the character of same and depth placed, from feet to
feet for each plug set.

100 sks. common, 2% gel, 3% c.c.:
50 sks @ 450'; 30 sks @ 210'
10 sks @ 40', 10 sks rathole,
Plug down 10:45 PM, 6/29/81
By Allied

(If additional description is necessary, use BACK of this sheet)

Name of Plugging Contractor Allen Drilling Company

RECEIVED
STATE CORPORATION COMMISSION

STATE OF KANSAS COUNTY OF BARTON

Roy Goans (employee of owner) or (owner or operator)

of the above-described well, being first duly sworn on oath, says: That I have knowledge of
the facts, statements, and matters herein contained and the log of the above-described well
as filed and that the same are true and correct. So help me God.

(Signature) Roy Goans
P.O. Box 1389, Great Bend, KS 67530
(Address)

SUBSCRIBED AND SWORN TO before me this 2nd day of July, 1981



Ruth Brack
Notary Public.

My commission expires

DRILLER'S WELL LOG

DATE COMMENCED: 06/24/81
DATE COMPLETED: 06/29/81

R & B Petroleum, Inc.
DEEDS "C" No. 1
SW NW NW
Sec. 13, Twp. 18, Rge. 7W,
Rice County, Kansas

ELEVATION: 1668' G.L.
1673' K.B.

FORMATION DATA:

2560 - 2604' Shale
2604 - 2684' Shale
2684 - 2731' Lime & shale
2731 - 3079' Lime
3079 - 3137' Lime & shale
3137 - 3168' Sand
3168 - 3204' Shale
3204 - 3262' Sand
3262 - RTD

Heebner 2560'
Douglas 2604'
Brown Lime 2684'
Lansing 2731'
Base KC 3079'
Cherokee 3137'
Kinderhook 3168'
Misener 3204'
RTD 3262'

SURFACE DATA:

Ran 5 jts. 20# new 8-5/8" casing; tally: 198' Set @ 205' w/ 130 sks/poz.; 2% gel, 3% c.c., Plug down 1:45 P.M. 6/24/81, By Sun

PLUGGING DATA:

100 sks com., 2% gel, 3% c.c.:
50 sks @ 450; 30 sks @ 210',
10 sks @ 40', 10 sks rathole,
Plug down 10:45 PM, 6/29/81
By Allied

RECEIVED
STATE CORPORATION COMMISSION

A F F I D A V I T

JUL - 8 1981

STATE OF KANSAS)
COUNTY OF BARTON) ss.

CONSERVATION DIVISION
Wichita, Kansas

Roy Goans, of lawful age, does swear and state that the facts and statements herein contained are true and correct to the best of his knowledge.

Roy Goans

Subscribed and Sworn to before me this 2nd day of July, 1981.



Ruth Brack
Notary Public