

STATE OF KANSAS
STATE CORPORATION COMMISSION


Give All Information Completely
Make Required Affidavit
Major Deliner Report to:
Conservation Division
State Corporation Commission
211 N. Broadway
Wichita, Kansas

WELL PLUGGING RECORD

RICE County, Sec. 13 Twp. 18S Rge. 7 (X) (W)

Location as "NE/CNWxSWx" or footage from lines. SW NE NE
Lease Owner PETROLEUM, INC.,
Lease Name BRONLEWE "D" Well No. 1
Office Address R.R. #2, GREAT BEND, KANSAS
Character of Well (completed as Oil, Gas or Dry Hole) DRY HOLE
Date well completed NOVEMBER 3 19 65
Application for plugging filed NOVEMBER 3 19 65
Application for plugging approved NOVEMBER 3 19 65
Plugging commenced NOVEMBER 3 19 65
Plugging completed NOVEMBER 3 19 65
Reason for abandonment of well or producing formation NO PRODUCIBLE ZONE

NORTH

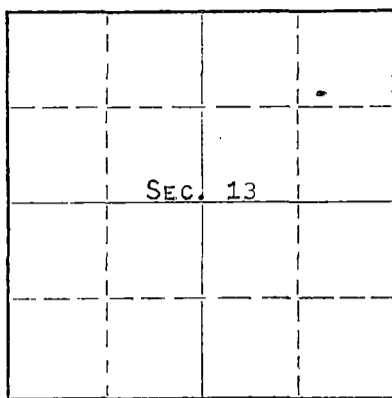

Locate well correctly on above
Section Plat

If a producing well is abandoned, date of last production NONE 19
Was permission obtained from the Conservation Division or its agents before plugging was commenced? YES

Name of Conservation Agent who supervised plugging of this well GILBERT TOMAN
Producing formation _____ Depth to top _____ Bottom _____ Total Depth of Well 3365 Feet
Show depth and thickness of all water, oil and gas formations.

OIL, GAS OR WATER RECORDS

CASING RECORD

FORMATION	CONTENT	FROM	TO	SIZE	PUT IN	PULLED OUT
				8-5/8	229	NONE

Describe in detail the manner in which the well was plugged, indicating where the mud fluid was placed and the method or methods used in introducing it into the hole. If cement or other plugs were used, state the character of same and depth placed, from _____ feet to _____ feet for each plug set.

MUDDER UP WITH HEAVY MUD TO 225', SET BRIDGE TO HOLD DRILL PIPE W/2 SACKS DRY CEMENT, 1/2 SACK HULLS, SET HALLIBURTON PLUG W/23 SACKS CEMENT. MUDDER UP WITH HEAVY MUD TO 40', BRIDGE W/1 SACK DRY CEMENT & 1/3 SACK HULLS, SET HALLIBURTON PLUG W/9 SACKS CEMENT TO BASE OF WELL CELLAR.

RECEIVED
STATE CORPORATION COMMISSION

NOV 16 1965

CONSERVATION DIVISION
Wichita, Kansas

11-16-1965

(If additional description is necessary, use BACK of this sheet)

Name of Plugging Contractor GARVEY DRILLING COMPANY
Address R.R. #2, GREAT BEND, KANSAS

STATE OF KANSAS, COUNTY OF BARTON, ss.
MONTE CHADD (employee of owner) or (~~owner or operator~~) of the above-described well, being first duly sworn on oath, says: That I have knowledge of the facts, statements, and matters herein contained and the log of the above-described well as filed and that the same are true and correct. So help me God. MONTE CHADD DIST. PROD. SUPT.

(Signature) *Monte Chadd*
ROUTE #2, GREAT BEND, KANSAS
(Address)

SUBSCRIBED AND SWORN to before me this 15 day of NOVEMBER, 19 65

My commission expires MAY 28, 1969

Richard H. Dumble
Notary Public.

WELL LOG

15.159.30205.00.00

COMPANY **Petroleum, Inc.**

SEC. 13 T. 18S R. 7W

FARM **Bronleewe**

NO. **1**

LOC. **SW NE NE**


TOTAL DEPTH **3365'**

COUNTY **Rice**

COMM. **10-26-65**

COMP. **11-3-65**

CONTRACTOR **Garvey Drilling Company**

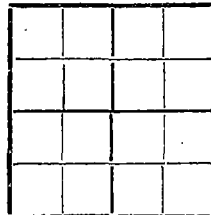

CASING **8 5/8" @ 229' w/175 sx**

ELEVATION **1694' KB**

PRODUCTION **D & A**

FIGURES INDICATE BOTTOM OF FORMATIONS

- 70' Clay and Post Rock
- 250' Shale
- 405' Red Bed and Shale
- 445' Anhydrite
- 945' Red Bed, Shale, and Shells
- 1570' Lime and Shale
- 1720' Lime and Shale Streaks
- 2095' Shale and Lime Streaks
- 2375' Shale and Lime
- 2605' Lime and Shale
- 2640' Shale
- 2900' Lime and Shale
- 3169' Lime
- 3272' Shale and Sand
- 3310' Shale
- 3365' Shale and Lime
- 3365' RTD

RECEIVED
STATE CORPORATION COMMISSION

NOV 16 1965

CONSERVATION DIVISION
Wichita, Kansas

State of Kansas }
County of Barton } SS

I, Sam N. Stephens of Garvey Drilling Company

upon oath state the above and foregoing is a true and correct copy of the log of the Bronleewe No. 1 well.

Sam N. Stephens

Subscribed and sworn to before me this 12th day of November 19 65

My Commission Expires: May 28, 1969

Richard N. Duncker
NOTARY PUBLIC