


STATE OF KANSAS  
STATE CORPORATION COMMISSION

WELL PLUGGING RECORD

Give All Information Completely  
Make Required Affidavit  
Mail or Deliver Report to:  
Conservation Division  
State Corporation Commission  
800 Bitting Building  
Wichita, Kansas

Rice County, Sec. 29 Twp. 18S Rge. 9W (E) (W)  
Location as "NE/CNW $\frac{1}{4}$ SW $\frac{1}{4}$ " or footage from lines SE NE NE  
Lease Owner J. C. Dozier, The Carl Todd Drilling Company, et al  
Lease Name McAtee Well No. 1  
Office Address 404 K F H Building, Wichita 2, Kansas  
Character of Well (completed as Oil, Gas or Dry Hole) dry hole  
Date well completed October 15, 1950  
Application for plugging filed October 17, 1950  
Application for plugging approved October 17, 1950  
Plugging commenced October 15, 1950  
Plugging completed October 15, 1950  
Reason for abandonment of well or producing formation dry hole

NORTH

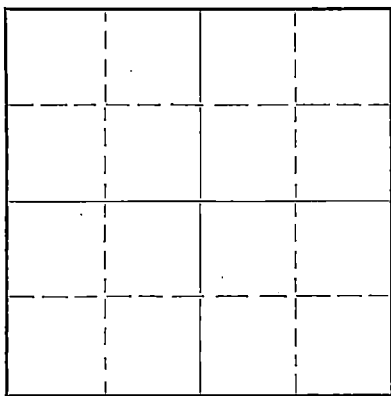

Locate well correctly on above  
Section Plat

If a producing well is abandoned, date of last production 19  
Was permission obtained from the Conservation Division or its agents before plugging was commenced? by telephone

Name of Conservation Agent who supervised plugging of this well Ruel Durkee  
Producing formation Depth to top Bottom Total Depth of Well 3305 Feet  
Show depth and thickness of all water, oil and gas formations.

OIL, GAS OR WATER RECORDS

CASING RECORD

Formation	Content	From	To	Size	Put In	Pulled Out
				8 5/8"	200	none

Describe in detail the manner in which the well was plugged, indicating where the mud fluid was placed and the method or methods used in introducing it into the hole. If cement or other plugs were used, state the character of same and depth placed, from feet to feet for each plug set.

Filled hole with heavy mud to 210'. Bridged with wooden plug and plugged with 15 sacks cement down drill pipe and then filled with heavy mud within 15' of surface. Bridged with wooden plug and filled with 5 sacks cement to bottom of cellar.

10-18-1950  
DIVISION  
OCT 18 1950  
KANSAS


(If additional description is necessary, use BACK of this sheet)  
Correspondence regarding this well should be addressed to The Carl Todd Drilling Company  
Address 404 K F H Building, Wichita 2, Kansas

STATE OF Kansas, COUNTY OF Sedgwick, ss.  
Carl Todd (employee of owner) or (owner or operator) of the above-described well,  
being first duly sworn on oath, says: That I have knowledge of the facts, statements, and matters herein contained and the log of the above-described well as filed and that the same are true and correct. So help me God.

(Signature) Carl Todd  
404 K F H Building, Wichita 2, Kansas  
(Address)

SUBSCRIBED AND SWORN TO before me this 17th day of October, 1950.  
Martha Loeff Notary Public.

My commission expires May 17, 1954 22-7877-s 4-49-10M

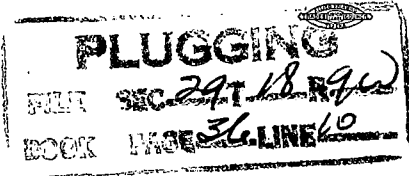

THE CARL TODD DRILLING COMPANY  
 404 KFH Building  
 Wichita 2, Kansas

Dozier, Todd Drilling, et al  
 McATEE No. 1  
 SE NE NE 29-18S-9W  
 Rice County, Kansas

Date Commenced: October 6, 1950  
 Date Completed: October 15, 1950  
 Elevation: 1722 D.F.  
 Rotary Tools: 0' to 3305' T.D.

Casing Record:

8-5/8" cemented at 218' with  
 150 sacks cement

Log

Formation Tops

0	35	Surface clay, shale
35	140	Sand, shale
140	235	Shale, shells
235	290	Red bed
290	405	Red bed, shells
405	910	Anhydrite
910	1015	Shale, salt
1015	1150	Shale, shells
1150	1205	Lime, shale
1205	1340	Broken lime
1340	1495	Lime
1495	2495	Lime, shale
2495	2785	Lime
2785	2900	Lime, shale
2900	3200	Lime
3200	3244	Lime, shale
3244	3255	Chert conglomerate
3255	3305	Arbuckle lime, Total Depth

Heebner . . . . .	2749
Brown Lime . . . . .	2873
Lansing . . . . .	2897
Conglomerate . . . . .	3244
Arbuckle . . . . .	3255

D & A

I, Carl Todd, do hereby certify that  
 the above log is correct to the best  
 of my knowledge and belief.

*Carl Todd*

RECEIVED  
 STATE CORPORATION COMMISSION  
 OCT 18 1950  
 CONSERVATION DIVISION  
 Wichita, Kansas

**PLUGGING**  
 FILE SEC. 29-18-9W  
 BOOK PAGE 36 LINE 10