

STATE OF KANSAS
STATE CORPORATION COMMISSION


WELL PLUGGING RECORD

Give All Information Completely
Make Required Affidavit
Mail or Deliver Report to:
Conservation Division
State Corporation Commission
800 Biting Building
Wichita, Kansas

OR
FORMATION PLUGGING RECORD

Strike out upper line
when reporting plug-
ging off formations.

Rice County. Sec 29 Twp 18 Rge 9 (E) (W)
Location as "NE $\frac{1}{4}$ NW $\frac{1}{4}$ SW $\frac{1}{4}$ " or footage from lines M/E $\frac{1}{2}$ NE $\frac{1}{2}$ SE $\frac{1}{4}$
Lease Owner Earl F. Wakefield, et al
Lease Name Chase Well No. 1
Office Address 307 Union Nat'l Bank Bldg. Wichita, Kansas
Character of Well (completed as Oil, Gas or Dry Hole) dry
Date well completed 6/14/41 19
Application for plugging filed 6/15/41 19
Application for plugging approved 6/16/41 19
Plugging commenced 6/16/41 19
Plugging completed 6/16/41 19
Reason for abandonment of well or producing formation dry
If a producing well is abandoned, date of last production 19
Was permission obtained from the Conservation Division or its agents before plugging was com-
menced?

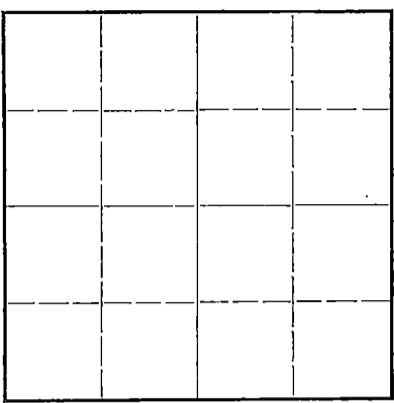

Locate well correctly on above
Section Flat

Name of Conservation Agent who supervised plugging of this well
Producing formation Depth to top Bottom Total Depth of Well Feet
Show depth and thickness of all water, oil and gas formations.

OIL, GAS OR WATER RECORDS CASING RECORD


Formation	Content	From	To	Size	Put In	Pulled Out
				15 1/2"	154'	154'
				12 1/2"	380'	380'
				10"	1670'	UR1795'
				6 5/8	2897	2897
				5 3/16	3202	3202'

Describe in detail the manner in which the well was plugged, indicating where the mud fluid was placed and the method or methods used in introducing it into the hold. If cement or other plugs were used, state the character of same and depth placed, from feet to feet for each plug set.

Hole filled with mud to 380' and cement with 20 sx of cement and filled with mud to top.

(If additional description is necessary, use BACK of this sheet)

Correspondence regarding this well should be addressed to Earl F. Wakefield
Address 307 Union National Bank Bldg.

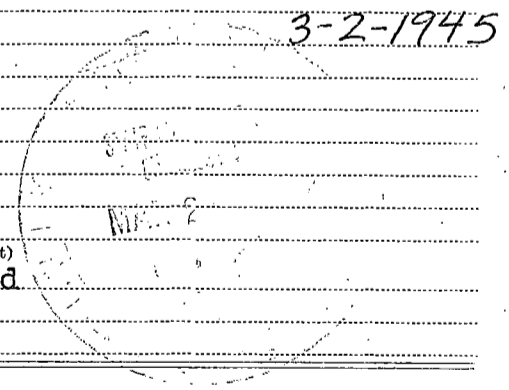

29 18 9W
141 32

STATE OF Kansas, COUNTY OF Sedgwick, ss.

Earl F. Wakefield (employee of owner) or (owner or operator) of the above-described well, being first duly sworn on oath, says: That I have knowledge of the facts, statements, and matters herein contained and the log of the above-described well as filed and that the same are true and correct. So help me God.

(Signature) Earl F. Wakefield
307 Union Nat'l Bank Bldg.
(Address)

SUBSCRIBED AND SWORN TO before me this 1st day of March, 1945

Rosemary Jones
Notary Public.

My commission expires 3-24-48

Farm: Chase
 Contractor: Earl F. Wakefield
 Comm: 5-9-41 Comp: 6-14-41

Description: Middle E $\frac{1}{2}$ NE $\frac{1}{4}$ SE $\frac{1}{4}$
 29-18-9

13. 124. 0048 8. 00. 00

	154'	6 5/8"	2897'
15 1/2"	154'	6 5/8"	2897'
12 3/8"	380'	5 3/16"	3202'
10"	1670' UR 1795'		
cellar	10	shale brown	1860
clay yellow	40	lime	1880
sand	50	shale blue	1885
2 BW 40-50		lime	1935
shale blue	80	shale blue	1940
sand	130	lime	1950
HPW 80-95		shale	1955
shale blue	215	lime	1960
shale light	230	shale blue	2035
red rock	378	shale brown	2039
lime	392	lime	2044
shale blue	395	shale blue	2075
12 1/8" pipe	390	lime	2080
red rock	450	shale blue	2160
blue shale	490	lime	2175
red rock	650	shale blue	2207
shale blue	700	lime broken	2225
red rock	740	lime white	2233
shale blue	850	shale	2240
salt	860	lime	2255
blue shale	870	shale	2260
1 BW 890-900		lime	2280
salt	1123	shale blue	2300
shale lime shells	1132	lime	2310
salt	1150	shale blue	2331
shale blue	1160	lime	2335
lime	1170	shale blue	2345
shale shells	1200	2 BW 2345-2350	
lime	1210	sand	2360
shale light	1230	shale	2375
lime white	1240	shale blue	2470
shale light	1252	lime	2590
lime	1320	shale blue	2600
shale blue	1340	lime	2750
lime	1377	shale blue	2762
shale blue	1385	lime	2772
lime	1392	shale blue	2775
red rock	1405	lime	2780
lime	1435	shale blue	2795
shale blue	1440	shale sandy	2810
lime	1548	shale	2868
3 BW PH 1515-1530		shale & shells	2893
shale blue	1555	6 5/8" pipe	2897
lime	1575	lime	2913
shale blue	1590	shale blue	2916
lime	1605	lime	2945
shale	1610	shale blue	2952
lime	1615	lime	3000
shale blue	1625	4 BW 2990-3000	
lime	1630	shale blue	3008
shale	1638	lime hard	3030
red rock	1645	lime	3040
lime	1655	shale blue	3048
shale blue	1659	lime	3062
lime	1661	red rock	3065
shale blue	1665	lime	3080
red rock	1670	sand	3095
lime	1680	HPW 3080-3095	
3 BW 1670-1680		corrected 3095-3108	
shale blue	1690	lime	3185
red rock	1698	shale blue	3195
lime	1710	red rock	3197
red rock	1717	shale	3202
lime	1720	5 3/16" pipe	3200
shale blue	1723	red rock	3211
lime	1745	lime	3216
shale blue	1755	conglomerate	3270
10" pipe	1670	lime	3305 T.D.
lime	1770	HPW 3300-3305	
shale	1780	slight show of oil	3294-3300
lime	1825	top lansing	2904
shale	1835	top conglomerate	3215
lime	1850	top simpson	3260
		top arbutle	3269-3305

29 18 9w
 141 32

