

STATE OF KANSAS
STATE CORPORATION COMMISSION

WELL PLUGGING RECORD

Give All Information Completely
Make Required Affidavit
Mail or Deliver Report to:
Conservation Division
State Corporation Commission
800 Biltmore Building
Wichita, Kansas

Rice

County. Sec. 26 Twp. 18 Rge. (E) 9 (W)

Location as "NE/CNW $\frac{1}{4}$ SW $\frac{1}{4}$ " or footage from lines C SW NE NW

Lease Owner Donald T. Ingling

Lease Name Kern "A" Well No. 1

Office Address Wichita, Kansas

Character of Well (completed as Oil, Gas or Dry Hole) Dry Hole

Date well completed 6-24-52 19

Application for plugging filed 6-28-52 19

Application for plugging approved 6-28-52 19


Plugging commenced 6-28-52 19

Plugging completed 7-2-52 19

Reason for abandonment of well or producing formation dry

If a producing well is abandoned, date of last production 19

Was permission obtained from the Conservation Division or its agents before plugging was commenced? Yes

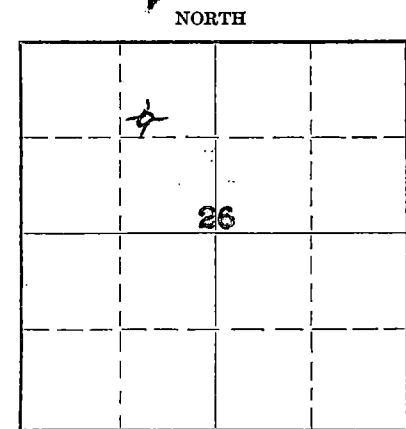

Locate well correctly on above Section Plat

Name of Conservation Agent who supervised plugging of this well Ruell Durkee

Producing formation Depth to top Bottom Total Depth of Well 3267 Feet

Show depth and thickness of all water, oil and gas formations.

OIL, GAS OR WATER RECORDS

CASING RECORD

Formation	Content	From	To	Size	Put In	Pulled Out
				8-5/8"	195'	None
				5-1/2"	3265'	2839'

Describe in detail the manner in which the well was plugged, indicating where the mud fluid was placed and the method or methods used in introducing it into the hole. If cement or other plugs were used, state the character of same and depth placed, from feet to feet for each plug set.

Sanded hole from 3269' to 3230' and ran 5 sacks of cement. Mudded hole to 191', bailed hole and set rock bridge from 191' to 180'. Ran 15 sacks of cement. Mudded hole to 30', set 10' rock bridge and ran 5 sacks of cement. Plugging completed.

RECEIVED
STATE CORPORATION COMMISSION

JUL 16 1952 7-16-1952

CONSERVATION DIVISION
Wichita, Kansas

(If additional description is necessary, use BACK of this sheet)

Correspondence regarding this well should be addressed to DONALD T. INGLING
Address 611 ORPHEUM BUILDING
WICHITA 2, KANSAS

STATE OF KANSAS, COUNTY OF SEDGWICK, ss.

D. T. Ingling (employee of owner) or (owner or operator) of the above-described well, being first duly sworn on oath, says: That I have knowledge of the facts, statements, and matters herein contained and the log of the above-described well as filed and that the same are true and correct. So help me God.

(Signature) [Signature]

611 Orpheum Bldg., Wichita 2, Kansas (Address)

SUBSCRIBED AND SWORN TO before me this 7th day of July, 1952

[Signature] Notary Public.

My commission expires February 27, 1956

23-3273-s 4-50-10M

PLUGGING
FILE SEC 26 T 18 R 9W
BOOK PAGE 28 LINE 17

WELL LOG - KERN NO. 1-A

Donald T. Ingling, et al, Lease Owner

Sec. 26-18-9W

Donald T. Ingling, Operator

Location: C SW NE NW

Commenced: 5-24-52

County: Rice, Kansas

Completed: 6-20-52 (rotary)

Production: DRY

Total Depth: 3267'

Elevation: 1722 DF

Casing: 8 5/8" - 195'
5 1/2" - 3265'

Figures below indicate bottom formation:

40	Clay	2630	Lime
60	Sand	2665	Lime
120	Shale	2700	Lime
195	Shale and shells	2726	Lime
600	Red rock and shale	2800	Lime
830	Shale and shells	2870	Lime and shale
875	Shale and shells	2900	Lime
1050	Salt and shale	2930	Lime
1100	Shale and shells	2958	Lime
1280	Shale and lime	2990	Lime
1380	Lime and shale	3020	Lime
1460	Shale and lime	3060	Lime
1490	Lime and shale	3095	Lime
1605	Lime	3127	Lime
1675	Lime	3150	Lime
1770	Lime	3190	Lime
1855	Lime streaks and shale	3203	Lime
1980	Lime and shale	3235	Conglomerate
2080	Lime	3245	Conglomerate
2235	Shale and lime	3247	Sand
2350	Lime and shale	3267	Sand and shale
2360	Lime and shale	3267	Total Depth
2400	Lime and shale		
2460	Lime		
2510	Lime and shale		
2545	Lime		
2590	Lime		

I hereby certify this is a true and correct log of the above mentioned well.

WICHITA CORPORATION COY. INCORPORATED

JUN 16 1952

CONSERVATION DIVISION
WICHITA, KANSAS

Donald T. Ingling
DONALD T. INGLING

Subscribed and sworn to before me, a Notary Public in said County and State this 23rd day of June, 1952

W. E. Black
NOTARY PUBLIC

My commission expires February 27, 1956

PLUGGING
FILE SEC-26T-18-R-9W
BOOK PAGE-28 LINE-17