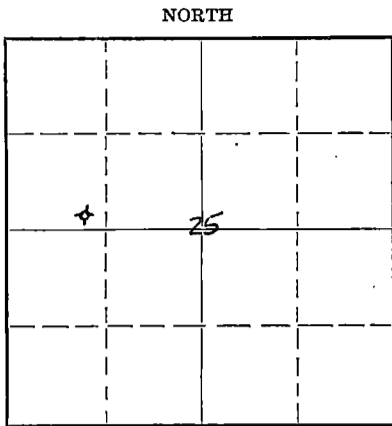


STATE OF KANSAS  
STATE CORPORATION COMMISSION

WELL PLUGGING RECORD

Give All Information Completely  
Make Required Affidavit  
Mail or Deliver Report to:  
Conservation Division  
State Corporation Commission  
800 Bitting Building  
Wichita, Kansas

Rice County. Sec. 25 Twp. 18 Rge. (E) 9 (W)  
Location as "NE/CNW $\frac{1}{4}$ SW $\frac{1}{4}$ " or footage from lines C SE SW NW  
Lease Owner Donald T. Ingling, et al  
Lease Name Kottmann Well No. 1  
Office Address 611 Orpheum Bldg., Wichita 2, Kansas  
Character of Well (completed as Oil, Gas or Dry Hole) Dry Hole  
Date well completed March 31, 1952  
Application for plugging filed March 31, 1952  
Application for plugging approved March 31, 1952  
Plugging commenced March 31, 1952  
Plugging completed March 31, 1952  
Reason for abandonment of well or producing formation Dry



Locate well correctly on above  
Section Plat

If a producing well is abandoned, date of last production 19  
Was permission obtained from the Conservation Division or its agents before plugging was commenced? Yes

Name of Conservation Agent who supervised plugging of this well Ruel Durkes, McPherson, Kansas  
Producing formation Depth to top Bottom Total Depth of Well 3382 Feet  
Show depth and thickness of all water, oil and gas formations.

OIL, GAS OR WATER RECORDS

CASING RECORD

Formation	Content	From	To	Size	Put In	Pulled Out
				8 5/8"	200'	None

Describe in detail the manner in which the well was plugged, indicating where the mud fluid was placed and the method or methods used in introducing it into the hole. If cement or other plugs were used, state the character of same and depth placed, from feet to feet for each plug set.

Pumped heavy mud one hour, laid down one-half drill pipe then pumped heavy mud half hour and laid down balance of drill pipe. Put plug at 200 feet then 15 sacks of cement and heavy mud to 20 feet where we put top plug - then 5 sacks of cement to surface.

(If additional description is necessary, use BACK of this sheet)

Name of Plugging Contractor Donald T. Ingling  
Address 611 Orpheum Building, Wichita 2, Kansas

STATE OF KANSAS, COUNTY OF SEDGWICK, ss.  
Donald T. Ingling (employee of owner) or (owner or operator) of the above-described well, being first duly sworn on oath, says: That I have knowledge of the facts, statements, and matters herein contained and the log of the above-described well as filed and that the same are true and correct. So help me God.

(Signature) Donald T. Ingling  
611 Orpheum Building, Wichita 2, Kansas  
(Address)

SUBSCRIBED AND SWORN TO before me this 31st day of March, 19 52

My commission expires February 27, 1956  
Notary Public.

23-8890-s 6-51-20M

PLUGGING  
FILE SEC 25 T 18 R 9 W  
PAGE 5 LINE 40

APR 1 1952

4-1-1952

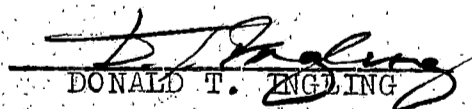
WELL LOG - KOTTMANN NO. 1

Donald T. Ingling, et al, Lease Owner      Sec. 25, Twsp. 18, Rnge. 9W  
 Donald T. Ingling, Contractor      Location:    C SE SW NW  
 Commenced:    March 12, 1952      County:    Rice, Kansas  
 Completed:    March 31, 1952      Production:    Dry  
 Casing:      8 5/8" - 200'      Elevation:      1739 D.F.  
 Total Depth:      3382'

Figures below indicate bottom formation:

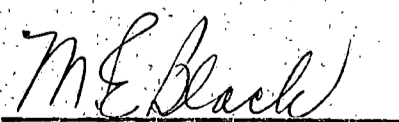
70	Surface shale	2665	Lime
170	Shale	2700	Lime
200	Shale and shells	2740	Lime
260	Shale and shells	2774	Lime
460	Red rock and shale	2810	Lime
645	Red rock and shale	2845	Lime
825	Shale and shells	2875	Lime and shale
930	Shale	2900	Lime
1010	Salt and shale	2925	Lime
1045	Shale and shells	2950	Lime
1195	Shale and lime	2960	Lime
1295	Lime and shale	2990	Lime
1365	Shale and lime	3050	Lime
1475	Shale and lime	3071	Lime
1560	Lime	3090	Lime
1620	Lime	3125	Lime
1680	Lime and shale	3155	Lime
1755	Lime and shale	3175	Lime
1820	Shale and lime	3197	Lime
1920	Shale and lime	3225	Lime
2040	Shale and lime	3238	Lime
2170	Shale and lime	3260	Conglomerate
2265	Lime and shale	3300	Conglomerate
2338	Shale and lime	3320	Conglomerate
2425	Lime and shale	3340	Simpson
2510	Lime	3360	Simpson
2555	Lime	3373	Conglomerate
2586	Lime	3382	Arbuckle
2630	Lime	3382	Total Depth

I hereby certify that this is a true and correct log of the above mentioned well.

  
 DONALD T. INGLING

STATE OF KANSAS      )  
                                   ) ss.  
 COUNTY OF SEDGWICK)

Subscribed and sworn to before me, a Notary Public in said County and State this 1st day of April, 1952

  
 NOTARY PUBLIC

My commission expires February 27, 1956

**PLUGGING**  
 FILE SEC 25 T 18 R 9W  
 BOOK 5 LINE 40