


WELL PLUGGING RECORD

Give All Information Completely
Make Required Affidavit
Mail or Deliver Report to:
Conservation Division
State Corporation Commission
211 No. Broadway
Wichita, Kansas

NORTH

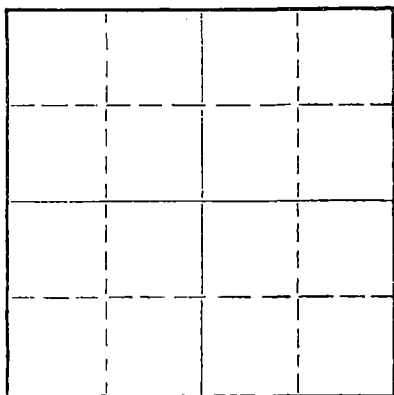

Locate well correctly on above
Section Plat

Rice County, Sec. 5 Twp. 18 Rge. 9 (E) W (W)
Location as "NE/CNW/SW" or footage from lines. NE NE NE
Lease Owner Abercrombie Drilling, Inc.
Lease Name Guldner Well No. 1
Office Address Wichita, Kansas
Character of Well (completed as Oil, Gas or Dry Hole) _____
Date well completed _____ 19____
Application for plugging filed _____ 19____
Application for plugging approved _____ 19____
Plugging commenced 1-21-65 _____ 19____
Plugging completed 1-26-65 _____ 19____
Reason for abandonment of well or producing formation Depleted.

If a producing well is abandoned, date of last production _____ 19____
Was permission obtained from the Conservation Division or its agents before plugging was commenced? yes

Name of Conservation Agent who supervised plugging of this well Gilbert Toman
Producing formation _____ Depth to top _____ Bottom _____ Total Depth of Well 3253 Feet
Show depth and thickness of all water, oil and gas formations.

OIL, GAS OR WATER RECORDS

CASING RECORD

FORMATION	CONTENT	FROM	TO	SIZE	PUT IN	PULLED OUT
				7-5/8"	240'	None
				4-1/2"	3248'	2964'

Describe in detail the manner in which the well was plugged, indicating where the mud fluid was placed and the method or methods used in introducing it into the hole. If cement or other plugs were used, state the character of same and depth placed, from _____ feet to _____ feet for each plug set.

Checked hole to 3253', sanded hole to 3235' and dumped 3 sacks of cement @ 3235' with dump bailer. Pulled 4 1/2" casing, bailed fluid to 240', set rock bridge to 230' and dumped 20 sacks of cement @ 230'. Mudded hole to 40', set rock bridge to 30' and ran 10 sacks of cement to base of cellar.

RECEIVED
STATE CORPORATION COMMISSION

JAN 27 1965

PLUGGING COMPLETE.

1-27-1965
CONSERVATION DIVISION
Wichita, Kansas

(If additional description is necessary, use BACK of this sheet)
Name of Plugging Contractor KNIGHT CASING PULLING COMPANY
Address CHASE, KANSAS

STATE OF KANSAS COUNTY OF RICE, ss.
Noel J. Knight (employee of owner) or ~~owner or operator~~ of the above-described well, being first duly sworn on oath, says: That I have knowledge of the facts, statements, and matters herein contained and the log of the above-described well as filed and that the same are true and correct. So help me God.

(Signature) Noel J. Knight
Chase, Kansas
(Address)

SUBSCRIBED AND SWORN TO before me this 26th day of January, 1965

My commission expires May 20, 1965
Milton J. Volin
Notary Public.

CONTRACTOR'S WELL LOG

COMPANY: Abercrombie Drilling, Inc.
 CONTRACTOR: Abercrombie Drilling, Inc.
 FARM: GULDNER #1
 LOCATION: NE NE SE Sec. 5-18S-9W
 Rice County, Kansas
 COMMENCED: December 23, 1964
 COMPLETED: January 11, 1965

0	240	Sand Shale and Shells
240	628	Shale and Shells
628	1064	Shale (Red)
1064	1108	Anhydrite
1108	1150	Shale
1150	2040	Lime and Shale
2040	2199	Shale with Lime Str.
2199	2608	Shale and Lime
2608	2780	Lime
2780	2845	Lime and Shale
2845	3253	Lime
	3253	Rotary Total Depth

Set 7-5/8" Surface Casing at 240' with 130 sacks common cement.

Set 4-1/2" at 3248' with 100 sacks salt saturated cement.

ELEVATION: 1754' D.F. & K.B.

TOPS:

Topeka	2488'	(-734)
Heebner	2759'	(-1005)
Toronto	2780'	(-1026)
Douglas	2791'	(-1037)
Brown Lime	2881'	(-1127)
Lansing	2898'	(-1144)
Arbuckle	3247'	(-1493)

RECEIVED
 STATE CORPORATION COMMISSION

JAN 27 1965

CONSERVATION DIVISION
 Wichita, Kansas

STATE OF KANSAS)
) SS
 COUNTY OF SEDGWICK)

I, B. Lynn Herrington, do hereby certify that the above and foregoing is a true and correct copy of the log of the GULDNER #1, NE NE SE, Section 5-18S-9W, Rice County, Kansas, as reflected by the files of Abercrombie Drilling, Inc.

B. Lynn Herrington
 B. Lynn Herrington

Subscribed and sworn to before me, a Notary Public, in and for Sedgwick County, Kansas, this 13th day of January, 1965.

Leah Faye Hefke
 Leah Faye Hefke, Notary Public

My commission expires June 16, 1967.