


STATE OF KANSAS
STATE CORPORATION COMMISSION

WELL PLUGGING RECORD

Give All Information Completely
Make Required Affidavit
Mail or Deliver Report to:
Conservation Division
State Corporation Commission
211 No. Broadway
Wichita, Kansas

Rice County. Sec. 3 Twp. 18S Rge. 9 (E) W(W)
Location as "NE/CNW/SW" or footage from lines SW SW SE
Lease Owner Eugene O. Huebner
Lease Name Asper Well No. 1
Office Address Bushton, Kansas
Character of Well (completed as Oil, Gas or Dry Hole) Dry Hole
Date well completed December 28 19 57
Application for plugging filed December 28 19 57
Application for plugging approved December 28 19 57
Plugging commenced December 28 19 57
Plugging completed December 28 19 57
Reason for abandonment of well or producing formation Failure to produce
in commercial quantities
If a producing well is abandoned, date of last production _____ 19 ____
Was permission obtained from the Conservation Division or its agents before plugging was commenced? Yes

NORTH

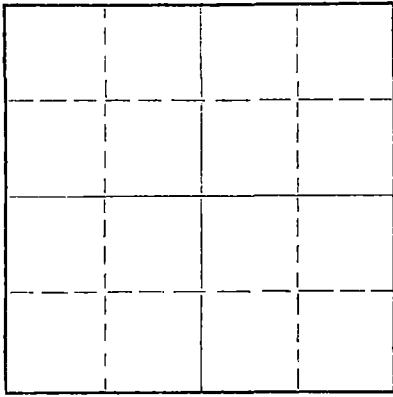

Locate well correctly on above
Section Plat

Name of Conservation Agent who supervised plugging of this well Earl Durkee
Producing formation _____ Depth to top _____ Bottom _____ Total Depth of Well 3273 Feet
Show depth and thickness of all water, oil and gas formations.

OIL, GAS OR WATER RECORDS

CASING RECORD

FORMATION	CONTENT	FROM	TO	SIZE	PUT IN	PULLED OUT
				8 5/8	209'	

Describe in detail the manner in which the well was plugged, indicating where the mud fluid was placed and the method or methods used in introducing it into the hole. If cement or other plugs were used, state the character of same and depth placed, from _____ feet to _____ feet for each plug set.

Bottom Plug @ 200' with plug and 1/2 sack hulls, 15 sacks cement.
Top Plug @ 40' with plug and 1/2 sack hulls, 10 sacks cement.

RECEIVED
STATE CORPORATION COMMISSION

DEC 31 1957 12-31-1957

CONSERVATION DIVISION
Wichita, Kansas

(If additional description is necessary, use BACK of this sheet)

Name of Plugging Contractor _____
Address _____

STATE OF KANSAS, COUNTY OF SEDGWICK, ss.
Richard A. Shelley (employee of owner) or (owner or operator) of the above-described well, being first duly sworn on oath, says: That I have knowledge of the facts, statements, and matters herein contained and the log of the above-described well as filed and that the same are true and correct. So help me God.

(Signature) Richard A. Shelley
205 Miller Building, Wichita, Kansas
(Address)

SUBSCRIBED AND SWORN to before me this 30 day of December, 19 57

Leona M. Powers
Notary Public.

My commission expires March 24, 1960

PLUGGING
FILE SEC 3 T 18 R 9a
BOOK PAGE 73 LINE 3

COMPANY: Eugene O. Huebner
Bushton, Kansas

Rotary Drilling Commenced: 12-16-57
Rotary Drilling Completed: 12-28-57

LOCATION: Asper No. 1
SW SW SE Sec. 3-18-9
Rice County, Kansas

CONTRACTOR: Shelley-Miller Drilling Company
205 Miller Building
Wichita, Kansas

CASING RECORD: 8 5/8 28# Casing set @ 209', cemented with 135 sacks cement.

L O G

(Measurements from top of Rotary Bushing to bottom of formation)

Sand	35
Shale & Shells	68
Red Bed	209
Shale & Shells	395
Anhydrite	431
Shale & Shells	1,290
Lime & Shale	1,865
Shale & Shells	2,085
Lime & Shale	2,580
Lime	3,220
Sand	3,237
Lime	3,273 Rotary T.D.

RECEIVED
STATE CORPORATION COMMISSION

DEC 31 1957

CONSERVATION DIVISION
Wichita, Kansas

The undersigned, Richard A. Shelley, Partner of Shelley-Miller Drilling Company, hereby certifies in behalf of said company, that the above log is a true and correct log of the formation encountered in drilling the above well as reflected by the Daily Drilling Reports.

SHELLEY-MILLER DRILLING COMPANY

By Richard A. Shelley

STATE OF KANSAS)
COUNTY OF SEDGWICK) SS

BE IT REMEMBERED, that on this 30th day of December, 1957, before me, the undersigned, a Notary Public, duly commissioned in and for the county and state aforesaid, came Richard A. Shelley, Partner, and known to me to be the same person who executed the foregoing instrument of writing in behalf of Shelley-Miller Drilling Company, as a Partner of said company, and he duly acknowledged the execution of the same for himself and for said company.

IN WITNESS WHEREOF, I have hereunto set my hand and official seal on the day and year last above written.

Leona M. Powers
Notary Public

My Commission Expires:
March 24, 1960

PLUGGING
FILE SEC 3 T 18 R 94
BOOK PAGE 13 LINE 3