

STATE OF KANSAS
STATE CORPORATION COMMISSION


Give All Information Completely
Make Required Affidavit
Mail or Deliver Report to:
Conservation Division
State Corporation Commission
211 No. Broadway
Wichita, Kansas

WELL PLUGGING RECORD

Rice County, Sec. 33 Twp. 18S Rge. 8 (X) W (W)

Location as "NE/CNW/SW" or footage from lines C SW SE
Lease Owner Wayne Merchant et al
Lease Name Casteen Well No. 1
Office Address 227 Beacon Building, Wichita, Kansas
Character of Well (completed as Oil, Gas or Dry Hole) Dry Hole
Date well completed December 29 19 64
Application for plugging filed December 29 19 64
Application for plugging approved December 29 19 64
Plugging commenced December 29 19 64
Plugging completed December 29 19 64
Reason for abandonment of well or producing formation Dry Hole

NORTH

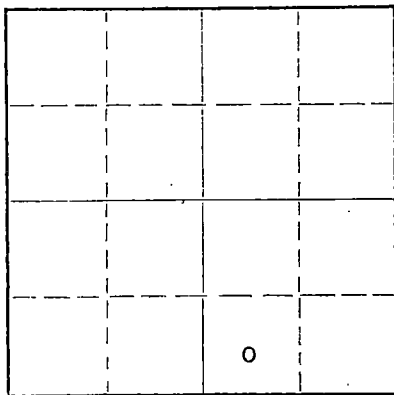

Locate well correctly on above
Section Plat

If a producing well is abandoned, date of last production 19
Was permission obtained from the Conservation Division or its agents before plugging was commenced? Yes

Name of Conservation Agent who supervised plugging of this well Gilbert Toman, Holyrood, Kansas
Producing formation None Depth to top Bottom Total Depth of Well Feet
Show depth and thickness of all water, oil and gas formations.

OIL, GAS OR WATER RECORDS

CASING RECORD

FORMATION	CONTENT	FROM	TO	SIZE	PUT IN	PULLED OUT
Surface soil, clay & sand		0	160	8 5/8	163	None

Describe in detail the manner in which the well was plugged, indicating where the mud fluid was placed and the method or methods used in introducing it into the hole. If cement or other plugs were used, state the character of same and depth placed, from feet to feet for each plug set.

- Filled hole with heavy mud to 160; HOWCO plug with 20 sacks cement mixed and displaced on top plug through the drill pipe
- Filled hole with heavy mud to 40; HOWCO plug with 10 sacks cement on top of plug
- Placed 2 sacks cement in rat hole

RECEIVED
STATE CORPORATION COMMISSION

JAN 5 1965

1-5-1965
CONSERVATION DIVISION
Wichita, Kansas

Name of Plugging Contractor Terrel Drilling & Producing
Address Box 606, Russell, Kansas

STATE OF KANSAS, COUNTY OF SEDGWICK, ss.
Wayne Merchant

(owner or operator) of the above-described well, being first duly sworn on oath, says: That I have knowledge of the facts, statements, and matters herein contained and the log of the above-described well as filed and that the same are true and correct. So help me God.

(Signature) Wayne Merchant
Wayne Merchant, 227 Beacon Building, Wichita, Ks
(Address)

SUBSCRIBED AND SWORN TO before me this 30th day of December, 19 64

My commission expires January 8, 1966

Jacqueline W. Kulas
Notary Public.



DRILLERS WELL LOG

CASTEEN No. 1
C SW SE Section 33-18s-8w
Rice County, Kansas

Commenced: Spud December 17, 1964
Completed: December 29, 1964

OPERATOR - Wayne Merchant et al

DEPTH		FORMATION	REMARKS
From	To		
0	160	Surface soil, clay & sand	Set 8 5/8" @ 163 w/135 sacks cement
160	2435	Lime & Shale	
2435	3183	Lime	
3183	3295	Lime & Shale	
3295	3500	Lime	
3500	TD		Dry & Abandoned

I, Wayne Merchant, certify this is a correct copy of the drillers log for the well drilled in the C SW SE Section 33-18s-8w, Rice County, Kansas to the best of my knowledge, information and belief.

Wayne Merchant
Wayne Merchant

STATE OF KANSAS)
COUNTY OF SEDGWICK) SS

Before me, the undersigned, a notary public within and for said county and state, on this 29th day of December, 1964, personally appeared Wayne Merchant to me personally known to be the identical person who executed the within and foregoing instrument and acknowledged to me that he executed the same as his free and voluntary act and deed for the uses and purposes therein set forth.

IN WITNESS WHEREOF, I have hereunto set my hand and official seal the day and year last above written.

Jacqueline O'Kearney
Notary Public

My commission expires January 8, 1966

RECEIVED
STATE CORPORATION COMMISSION
JAN 5 1965
CONSERVATION DIVISION
Wichita, Kansas