


15-159-00036-0000

STATE OF KANSAS  
STATE CORPORATION COMMISSION

Give All Information Completely  
Make Required Affidavit  
Mail or Deliver Report to:  
Conservation Division  
State Corporation Commission  
800 Bitting Building  
Wichita, Kansas

WELL PLUGGING RECORD

NORTH

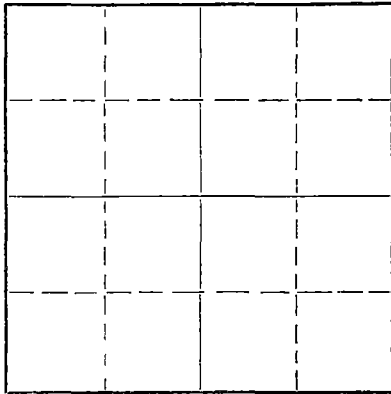

Locate well correctly on above  
Section Flat

Rice County. Sec. 27 Twp. 18S Rge. 8 (E) W (W)

Location as "NE/CNW%SW%" or footage from lines NE NE NE

Lease Owner Dozier Oil Company,

Lease Name Bether Well No. 1

Office Address Union National Bank Building, Wichita, Kansas.

Character of Well (completed as Oil, Gas or Dry Hole) Dry Hole.

Date well completed 10-17-52 19

Application for plugging filed 10-17-52 19

Application for plugging approved 10-17-52 19

Plugging commenced 10-17-52 19

Plugging completed 10-17-52 19

Reason for abandonment of well or producing formation Dry Hole.

If a producing well is abandoned, date of last production \_\_\_\_\_ 19

Was permission obtained from the Conservation Division or its agents before plugging was commenced? Yes

Name of Conservation Agent who supervised plugging of this well Ruel Durkee

Producing formation \_\_\_\_\_ Depth to top \_\_\_\_\_ Bottom \_\_\_\_\_ Total Depth of Well 3530 Feet

Show depth and thickness of all water, oil and gas formations.

OIL, GAS OR WATER RECORDS

CASING RECORD

FORMATION	CONTENT	FROM	TO	SIZE	PUT IN	PULLED OUT
		0	205	8 5/8"		

Describe in detail the manner in which the well was plugged, indicating where the mud fluid was placed and the method or methods used in introducing it into the hole. If cement or other plugs were used, state the character of same and depth placed, from 205 feet to 35 feet for each plug set.

Used two Halliburton Plugs. Pushed one plug to the depth of 205-Feet cemented with 15-sacks cement through drill pipe. Pushed top plug to the depth of 35-Feet cemented with 5-sacks cement.

10-23-1952

CONSERVATION DIVISION  
Wichita, Kansas

(If additional description is necessary, use BACK of this sheet)

Name of Plugging Contractor Stag Drilling Inc., Box 169, Chase, Kansas.

Address \_\_\_\_\_

STATE OF Kansas COUNTY OF Rice, ss.

C.L. Tyrrell (employee of owner) or (owner or operator) of the above-described

well, being first duly sworn on oath, says: That I have knowledge of the facts, statements, and matters herein-contained and the log of the above-described well as filed and that the same are true and correct. So help me God.

(Signature) C. L. Tyrrell


(Address) \_\_\_\_\_

SUBSCRIBED AND SWORN to before me this 22 day of Oct, 1952

Orlando Miller

Notary Public.

My commission expires 3/1/55

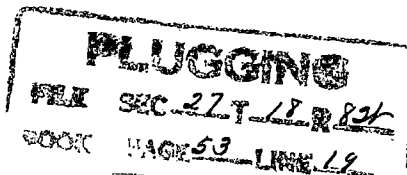

CONTRACTOR'S WELL LOG

OPERATOR Dozier Oil Co FARM NAME Bethers WELL NO. 1  
 LOCATION NE NE NE Sec. 27-18S COUNTY Rice STATE Kansas  
 COMMENCEMENT DATE 10/6/52 COMPLETION DATE 10/17/52

LOG OF WELL

\* All measurements from top of rotary bushing

FROM	TO	FORMATION	FORMATION from Vertical	REMARKS
0	205	Surface Soil		
205	345	Shale & Shells		
345	355	Sandy lime		
355	840	Shale Shells		
840	1040	Salt		
1040	1380	Lime shale		
1380	1495	Sandy lime		
1495	1855	lime shale		
1855	2359	Shale Shells		
2359	2444	Lime Shale		
2444	2736	Lime		
2736	2741	Shale		
2741	2764	Lime		
2764	2865	Lime Shale sandy		
2865	3210	lime		
3210	3276	Lime Shale		
3276	3305	Congl.		
3305	3370	Shale Kinderhook		
3370	3395	Shale		
3395	3457	Viola		
3457	3463	Quartzite & P.T.		
3463	3500	Simpson		
3500	3530	Arbuckle	Total Depth	Dry Hole

Set 205' ( 9 jts) 8 5/8" casing

STATE OF KANSAS( SS  
 County of Rice )

The undersigned certifies that to the best of his knowledge and belief the above facts are true and correct.

STAG DRILLING INC.,

By: L. S. Durrell  
 President

Subscribed and sworn to before me this 22nd day of October, 1952

My Commission expires 3/1/55

Claudio Miller  
 Notary Public.

RECEIVED  
 STATE CORPORATION COMMISSION  
 OCT 24 1952  
 CONSERVATION DIVISION  
 Wichita, Kansas

FILED  
 OCT 27 1952  
 PAGE 53 LINE 19