

15.159.00635.00.00


STATE OF KANSAS
STATE CORPORATION COMMISSION

WELL PLUGGING RECORD

Give All Information Completely
Make Required Affidavit
Mail or Deliver Report to:
Conservation Division
State Corporation Commission
212 North Market, Insurance Bldg.
Wichita, Kansas

Rice County. Sec. 27 Twp. 18S Rge. (E) 8 (W)

Location as "NE/CNW/SW" or footage from lines: C NW NW
Lease Owner E. H. Adair Oil Co.
Lease Name Archibald Well No. 1
Office Address 1005 E. Second, Wichita, Kansas.
Character of Well (completed as Oil, Gas or Dry Hole) Dry Hole
Date well completed 8-21-62 19__
Application for plugging filed 8-21-62 19__
Application for plugging approved 8-21-62 19__
Plugging commenced 8-21-62 19__
Plugging completed 8-21-62 19__
Reason for abandonment of well or producing formation _____

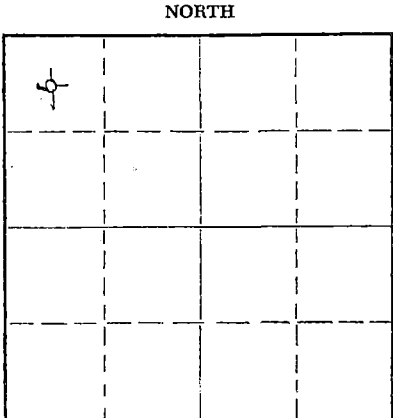

Locate well correctly on above
Section Plat

If a producing well is abandoned, date of last production _____ 19__
Was permission obtained from the Conservation Division or its agents before plugging was commenced? Yes

Name of Conservation Agent who supervised plugging of this well Donald Truan
Producing formation _____ Depth to top _____ Bottom _____ Total Depth of Well 3470 Feet
Show depth and thickness of all water, oil and gas formations.

OIL, GAS OR WATER RECORDS

CASING RECORD

FORMATION	CONTENT	FROM	TO	SIZE	PUT IN	PULLED OUT
				8 5/8	290 ** 290'	

Describe in detail the manner in which the well was plugged, indicating where the mud fluid was placed and the method or methods used in introducing it into the hole. If cement or other plugs were used, state the character of same and depth placed, from _____ feet to _____ feet for each plug set.

Mud to 280', plug, 1/4 sack hulls, and 25 sax cement thru drill pipe

Mud to 35', plug, hulls and 10 sax cement.

2 sax cement in rathole.

RECEIVED
STATE CORPORATION COMMISSION
SEP 10 1962
9-10-1962
CONSERVATION DIVISION
Wichita, Kansas

(If additional description is necessary, use BACK of this sheet)
Name of Plugging Contractor E. H. Adair Oil Co.
Address 1005 E. Second, Wichita, Kansas.

STATE OF Kansas, COUNTY OF Sedgwick, ss.
I, K. W. Johnson, (employee of owner) or (owner or operator) of the above-described well, being first duly sworn on oath, says: That I have knowledge of the facts, statements, and matters herein contained and the log of the above-described well as filed and that the same are true and correct. So help me God.
(Signature) K. W. Johnson
K. W. Johnson
Wichita, Kansas.
(Address)

SUBSCRIBED AND SWORN TO before me this 5th day of September, 1962

My commission expires 9-15-65 _____ Notary Public.



E. H. Adair Oil Company
1005 East Second Street
Wichita 14, Kansas.

E. H. Adair Oil Company, et al
No. 1 - Archibald
C - NW NW of
Sec. 27-Twp. 18S., Rge. 8 W.
Rice County, Kansas.

Elevation: 1,739 K.B.

Comm.: 8-14-62
Comp.: 8-21-62
Contractor:
Adair - Rig No. 3
8-5/8" s/csg. @
290 ft. w/250 sax.
Pro. D. & A.

Figures indicate bottoms of formations:

Shale and lime to	2035	Shale	to	2773
Shale	2116	Sand		2793
Lime	2132	Shale		2838
Shale	2185	Lime		2843
Lime	2242	Shale		2869
Shale	2265	Lime		3212
Lime	2298	Conglomerate		3297
Shale	2337	Shale and		
Lime	2400	little dolomite		3332
Shale	2438	Lime		3380
Lime	2710	Sandy dolo-		
Black shale	2714	mite		3386
Lime	2720	Shale		3392
Shale	2736	Sand		3400
Lime	2748	Shale & sandy		
		shale		3441
		Dolomite		3470
		R.T.D.		3470

Electric log tops:

TOPEKA	2436 (-697)
HEEBNER	2706 (-967)
DOUGLAS SHALE	2745 (-1006)
DOUGLAS SAND	2770 (-1031)
BROWN LIME	2834 (-1095)
LANSING-KANSAS CITY	2867 (-1128)
BASE KANSAS CITY	3166 (-1427)
MARMATON	3194 (-1455)
SHALEY CONGLOMERATE	3208 (-1469)
CHERTY CONGLOMERATE	3252 (-1513)
MAQUOKETA SHALE	3295 (-1556)
VIOLA LIMESTONE	3329 (-1590)
SIMPSON DOLOMITE	3378 (-1639)
SIMPSON SHALE	3384 (-1645)
SIMPSON SAND	3390 (-1651)
ARBUCKLE DOLOMITE	3438 (-1699)
T.D.	3468 (-1729)

Certified correct:

K. W. Johnson
K. W. Johnson - Geologist.

RECEIVED
CORPORATION COMMISSION
SEP. 10 1962
CONSERVATION DIVISION
Wichita, Kansas