

STATE OF KANSAS
STATE CORPORATION COMMISSION


WELL PLUGGING RECORD

Give All Information Completely
Make Required Affidavit
Mail or Deliver Report to:
Conservation Division
State Corporation Commission
211 N. Broadway
Wichita, Kansas

Rice County. Sec. 29 Twp. 18 Rge. (E) 9 (W)

Location as "NE/CNW/SW" or footage from lines NW SE SW
Lease Owner Strata Drilling, Inc.
Lease Name Haxton Well No. 1
Office Address Box 355, Great Bend, Kansas
Character of Well (completed as Oil, Gas or Dry Hole) Dry Hole
Date well completed September 26 19 58
Application for plugging filed September 26 19 58
Application for plugging approved September 26 19 58
Plugging commenced September 26 19 58
Plugging completed September 26 19 58
Reason for abandonment of well or producing formation Dry Hole

NORTH

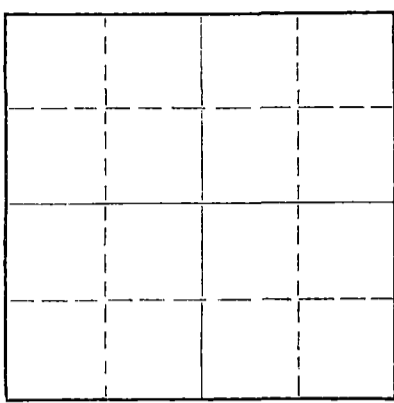

Locate well correctly on above
Section Plat

If a producing well is abandoned, date of last production _____ 19____
Was permission obtained from the Conservation Division or its agents before plugging was commenced? Yes

Name of Conservation Agent who supervised plugging of this well Gilbert Toman, Hollyrood, Kansas
Producing formation _____ Depth to top _____ Bottom _____ Total Depth of Well 3285 Feet
Show depth and thickness of all water, oil and gas formations.

OIL, GAS OR WATER RECORDS

CASING RECORD

FORMATION	CONTENT	FROM	TO	SIZE	PUT IN	PULLED OUT
				8-5/8"	255'	

Describe in detail the manner in which the well was plugged, indicating where the mud fluid was placed and the method or methods used in introducing it into the hole. If cement or other plugs were used, state the character of same and depth placed, from _____ feet to _____ feet for each plug set.

Plugged hole as follows: Plugged at 250' with 20 sacks of cement, 1/2 sack of hulls throught drillpipe, plug at 25' with 1/2 sack of hulls and 10 sacks of cement. Job completed at 10:00 A. M. on September 26, 1958.

(If additional description is necessary, use BACK of this sheet)

Name of Plugging Contractor Strata Drilling, Inc.
Address Box 355, Great Bend, Kansas

STATE OF KANSAS, COUNTY OF BARTON, ss.
Jim B. McWilliams (employee or owner or operator) of the above-described well, being first duly sworn on oath, says: That I have knowledge of the facts, statements, and matters herein contained and the log of the above-described well as filed and that the same are true and correct. So help me God.

(Signature) Jim B. McWilliams
Jim B. McWilliams
Box 355, Great Bend, Kansas
(Address)

SUBSCRIBED AND SWORN TO before me this 29th day of September, 19 58

My commission expires December 14, 1961
Elaine H. Taylor Notary Public.

OCT 2 1958
CONSERVATION DIVISION
WICHITA, KANSAS
10-2-1958

PLUGGING
FILE SEC 29 T. 18 R. 9W
BOOK PAGE 133 LINE 34

DRILLERS LOG

#1 Haxton

CASING RECORD: 249' of used 8-5/8" surface casing. COMPANY: Strata Drilling, Inc. DESCRIPTION: NW SE SW Section 29-18-9W Rice County, Kansas CONTRACTOR: Strata Drilling, Inc.

TOTAL DEPTH: 3285' COMMENCED: September 19, 1958 ELEVATION: 1728' KB COMPLETED: September 26, 1958

D. & A.

<u>FORMATIONS</u>	<u>FROM</u>	<u>TO</u>	<u>REMARKS</u>
Clay	0	80	Ran 255' (13 Jts.) of used 8-5/8" surface casing; cemented with 175 sacks of cement, 2% Gel and 2% Calcium Chloride.
Sandy Shale	80	135	
Shale & Shells	135	249	
Shale	249	410	
Red Bed & Shells	410	650	
Shale & Shells	650	1085	
Shale	1085	1150	
Shale & Lime	1150	1390	
Lime	1390	1805	
Shale & Lime	1805	1920	
Shale	1920	2415	
Shale & Lime	2415	3092	
Lime	3154	3285	

TOTAL DEPTH 3285'

Top Heebner	2759'	(-1031)
Top Brown Lime	2885'	(-1157)
Top Lansing	2907'	(-1179)
Top Arbuckle	3263'	(-1535)

STATE OF KANSAS)
 COUNTY OF BARTON) ss:

I certify that this is a true and correct copy of the above log to the best of my knowledge.

STRATA DRILLING, INC,

Jim B. McWilliams
 Jim B. McWilliams, Secy-Tres.

Subscribed and sworn to before me this 29th day of September, 1958.

Elaine H. Taylor
 Elaine H. Taylor - Notary Public

My Commission Expires:
 December 14, 1961

PLUGGING
 FILE SEC 29 T 18 R 9W
 BOOK PAGE 133 LINE 34