


6-16-1937

STATE OF KANSAS  
STATE CORPORATION COMMISSION

Give All Information Completely  
Make Required Affidavit.  
Mail or Deliver Report to:  
Conservation Division  
State Corporation Commission,  
800 Bitting Building,  
Wichita, Kansas

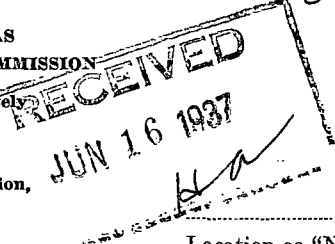


WELL PLUGGING RECORD

OR

FORMATION PLUGGING RECORD

Strike out upper line  
when reporting plugging  
off formations.

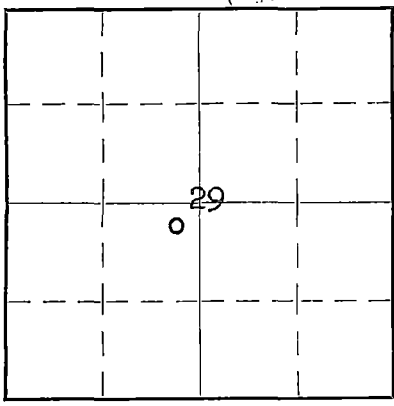

Locate well correctly on above  
Section Plat

Rice County. Sec. 29 Twp. 18S Rge. (E) 9 (W)

Location as "NE 1/4 NW 1/4 SW 1/4" or footage from lines NE NE SW 1/4  
Lease Owner Shell Petroleum Corporation et al  
Lease Name T. E. Haxton "B" Well No. B-1  
Office Address Box 744, Great Bend, Kansas  
Character of Well (Completed as Oil, Gas or Dry Hole) Dry Hole  
Date, well completed June 3 1937  
Application for plugging filed May 27 1937  
Application for plugging approved May 31 1937  
Plugging Commenced June 1 1937  
Plugging Completed June 3 1937  
Reason for abandonment of well or producing formation Dry Hole

If a producing well is abandoned, date of last production 193  
Was permission obtained from the Conservation Division or its agents before plugging was commenced? Yes

Name of Conservation Agent who supervised plugging of this well G. T. Alexander  
Producing formation Arbuckle-Siliceous Depth to top 3271 Bottom 3289 Total Depth of Well 3289 Feet  
Show depth and thickness of all water, oil and gas formations.


OIL, GAS OR WATER RECORDS

CASING RECORD

Formation	Content	From	To	Size	Put In	Pulled Out	
Arbuckle-Siliceous	Water	3274	3289	13"OD	205	None	
		500' of black sulphur water in 15 minute Halliburton Drill Stem Test.					

Describe in detail the manner in which the well was plugged, indicating where the mud fluid was placed and the method or methods used in introducing it into the hole. If cement or other plugs were used, state the character of same and depth placed, from...feet to...feet for each plug set.

Filled hole with heavy rotary mud from 3289' to 200'; drove 12 1/2" wooden plug to bottom of surface casing @ 205' and capped with 10 sax cement. Filled hole with heavy rotary mud from 205' to bottom of cellar. Drove 12 1/2" wooden plug at 16' and capped with 10 sax cement. Capped surface casing with 5 sax cement.

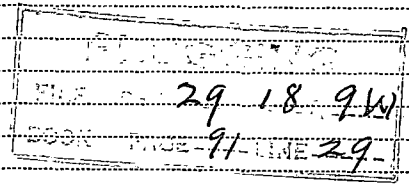

(If additional description is necessary use BACK of this sheet)

Correspondence regarding this well should be addressed to Mr. C. R. Bickel  
Address Box 744  
Great Bend, Kansas

STATE OF KANSAS, COUNTY OF BARTON, SS.  
C. R. BICKEL (employee of owner)

being first duly sworn on oath, says: That I have knowledge of the facts, statements, and matters herein contained and the log of the above-described well as filed and that the same are true and correct. So help me God.

(Signature) C. R. Bickel

Box 744, Great Bend, Kansas  
(Address)


SUBSCRIBED AND SWORN to before me this 14th day of JUNE, 1937.

My commission expires 12-1-40

Maria M. Stayton  
Notary Public.

## SHELL ET AL, T. E. HAXTON #B-1, NE NE SW SECTION 29-18S-9W.

0 - 97	Surface clay	1798	Shale
160	Sand	1805	Shale & shells
267	Shale & shells	1820	Lime
283	Red rock	1830	Red shale
325	Lime	1871	Lime
402	Shale	1877	Shale
514	Shells	1890	Sandy lime
598	Shale	1941	Broken lime
652	Sandy shale	1956	Shale
694	Shale & lime shells	1963	Lime
708	Shale & shells	1976	Shale & shells
730	Red shale	1984	Shale
754	Lime	1996	Lime
845	Shale & lime	2015	Shale
860	Shale	2023	Lime
884	Salt & shells	2033	Lime broken
1054	Salt	2040	Shale
1178	Salt & shale streaks	2066	Lime
1191	Lime	2077	Shale
1211	Shale	2127	Sticky shale
1237	Lime	2144	Sandy shale
1242	Shale	2168	Shale & shells
1289	Lime	2190	Lime
1296	Shale	2200	Lime
1306	Lime	2228	Shale
1321	Shale & lime shells	2233	Lime
1340	Lime	2246	Shale
1353	Shale	2254	Lime
1389	Shale & lime streaks	2260	Shale
1417	Broken lime	2267	Lime
1430	Shale	2291	Shale
1438	Sandy lime	2306	Lime
1454	Lime	2330	Shale
1461	Shale	2350	Lime broken
1479	Lime	2375	Shale shells
1494	Shale	2393	Shale
1500	Lime	2401	Lime
1529	Shale	2414	Shale
1541	Shale & lime shells	2429	Lime
1583	Lime	2441	Shale
1587	Sandy lime	2449	Shale & shells
1603	Lime	2526	Lime
1614	Shale	2526=2527	SLC (derrick floor)
1629	Lime	2537	Broken lime
1634	Shale	2554	Shale
1641	Lime	2573	Lime
1650	Shale	2579	Shale
1656	Lime	2585	Lime
1665	Shale	2588	Sand
1679	Lime	2605	Shale
1696	Shale & lime shells	2619	Lime
1698	Shells	2631	Broken lime
1703	Shale	2650	Lime
1714	Lime	2663	Shale
1722	Shale	2683	Lime
1737	Broken lime	2687	Shale

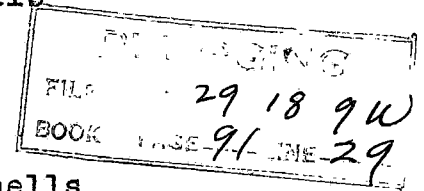

(continued)

SHELL ET AL, T. E. HAXTON #B-1, NE NE SW SECTION 29-18S-9W.

2687	2704	Lime
	2710	Broken lime
	2726	Lime
	2734	Shale
	2748	Lime
	2751	Shale
	2770	Lime
	2780	Lime broken
	2794	Shale
	2821	Sandy lime
	2844	Shale
	2855	Shale & shells
	2861	Lime
	2870	Shale
	2880	Lime
	2895	Shale
	2914	Shale shells
	3051	Lime
	3053	Broken lime
	3061	Lime
	3067	Shale
	3084	Lime
	3092	Broken lime
	3115	Lime
	3125	Lime broken
	3156	Lime
	3163	Broken lime
	3194	Lime
	3213	Shale
	3239	Shale & shells
	3250	Shale & sand streaks
	3271	Shale
	3289	Dolomite T.D.

FILE	29 18 9W
BOOK	PAGE 91 LINE 29