


WELL PLUGGING RECORD

Give All Information Completely
Make Required Affidavit
Mail or Deliver Report to:
Conservation Division
State Corporation Commission
211 No. Broadway,
Wichita, Kansas

NORTH

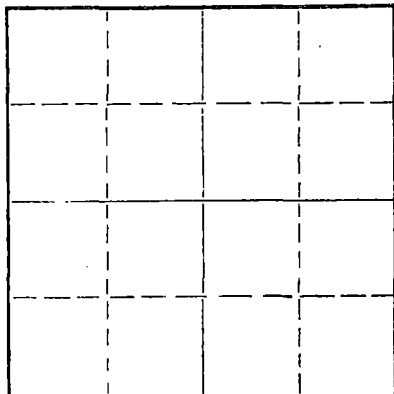

Locate well correctly on above Section Plat

Kiowa County, Sec. 29 Twp. 30S. Rge. 19 (X) (W)
Location as "NE/CNW/SW" or footage from lines SW SW SW
Lease Owner National Cooperative Refinery Association
Lease Name Koehn #1 (Washdown) Well No.
Office Address 305 Rule Building, Wichita, Kansas
Character of Well (completed as Oil, Gas or Dry Hole) Dry Hole
Date well completed 10-14-62 19
Application for plugging filed 10-14-62 19
Application for plugging approved 10-14-62 19
Plugging commenced 10-14-62 19
Plugging completed 10-14-62 19
Reason for abandonment of well or producing formation Dry Hole

If a producing well is abandoned, date of last production 19
Was permission obtained from the Conservation Division or its agents before plugging was commenced? yes

Name of Conservation Agent who supervised plugging of this well Eldon Petty, Hays, Kansas
Producing formation Depth to top Bottom Total Depth of Well 6040 Feet
Show depth and thickness of all water, oil and gas formations.

OIL, GAS OR WATER RECORDS

CASING RECORD

FORMATION	CONTENT	FROM	TO	SIZE	PUT IN	PULLED OUT
				8 5/8"	1023'	None

Describe in detail the manner in which the well was plugged, indicating where the mud fluid was placed and the method or methods used in introducing it into the hole. If cement or other plugs were used, state the character of same and depth placed, from feet to feet for each plug set.

1st plug set @ 390' with 1/2 sack of hulls and 20 sacks of cement.
2nd plug set @ 40' with 1/2 sack of hulls and 10 sacks of cement.

10-19-62
RECEIVED
STATE CORPORATION COMMISSION
OCT 19 1962
CONSERVATION DIVISION
Wichita, Kansas

(If additional description is necessary, use BACK of this sheet)

Name of Plugging Contractor Leben Drilling, Inc.
Address P. O. Box 486, Great Bend, Kansas

STATE OF KANSAS, COUNTY OF BARTON, ss.
Byron Johnson (employee of owner) or (owner or operator) of the above-described well, being first duly sworn on oath, says: That I have knowledge of the facts, statements, and matters herein contained and the log of the above-described well as filed and that the same are true and correct. So help me God.

(Signature) Byron Johnson
P. O. Box 486, Great Bend, Kansas
(Address)

SUBSCRIBED AND SWORN TO before me this 18th day of October, 1962

My commission expires April 1, 1963 Ulanda Nichols Notary Public.

INVOICED

DATE 10/19/62
INV. NO. 5891-W

DRILLER'S LOG

COMPANY:

CONTRACTOR:

FARM:

LOCATION:

COMMENCED:

COMPLETED:

RECEIVED
STATE CORPORATION COMMISSION
OCT. 19 1962
CONSERVATION DIVISION
Wichita, Kansas

National Cooperative Refinery
Association
LEBEN DRILLING, INC.
KOEHN #1 (Washdown)
SW SW SW Sec. 29-30S-19W
KIOWA COUNTY, KANSAS
10-1-62
10-14-62

0	5183	Washed down
5183	6010	Lime
6010	6040	Arbuckle lime
	<u>6040</u>	<u>Rotary Total Depth - D. & A.</u>

8 5/8" surface casing set by previous Operator.

I, Byron Johnson, do hereby certify that the above and foregoing is a true and correct copy of the log of the Koehn #1 (Washdown), located SW SW SW Section 29, Township 30 South, Range 19 West, Kiowa County, Kansas, as reflected by the files of Leben Drilling, Inc.

Byron Johnson
Byron Johnson

STATE OF KANSAS)
) SS
COUNTY OF BARTON)

Subscribed and sworn to before me, a Notary Public, in and for Barton County, Kansas, this 18th day of October, 1962.

Ulanda Nichols
Ulanda Nichols, Notary Public

My Commission Expires:
April 1, 1963