


STATE OF KANSAS  
STATE CORPORATION COMMISSION

Give All Information Completely  
Make Required Affidavit  
Mail or Deliver Report to:  
Conservation Division  
State Corporation Commission  
800 Bitting Building  
Wichita, Kansas

WELL PLUGGING RECORD

NORTH

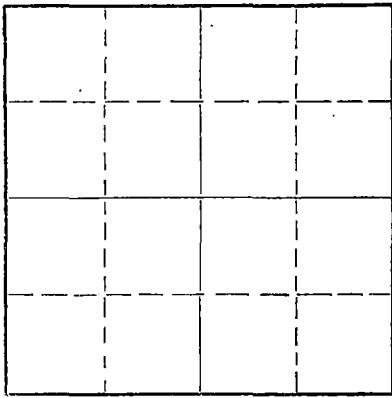

Locate well correctly on above  
Section Plat

Kiowa County: Sec. 29 Twp. 30 Rge. (E) 19 (W)

Location as "NE/CNW/SW" or footage from lines SW SW SW/4

Lease Owner M. B. Armer

Lease Name Jacob Koehn Well No. 1

Office Address 710 Petroleum Bldg., Wichita 2, Kans.

Character of Well (completed as Oil, Gas or Dry Hole) dry

Date well completed Jan. 11 19 53

Application for plugging filed Jan. 12 19 53

Application for plugging approved Jan. 12 19 53

Plugging commenced Jan. 12 19 53

Plugging completed Jan. 12 19 53

Reason for abandonment of well or producing formation dry

If a producing well is abandoned, date of last production 19

Was permission obtained from the Conservation Division or its agents before plugging was commenced? Yes

Name of Conservation Agent who supervised plugging of this well M. A. Rives

Producing formation Depth to top Bottom Total Depth of Well 5200 Feet

Show depth and thickness of all water, oil and gas formations.

OIL, GAS OR WATER RECORDS

CASING RECORD

FORMATION	CONTENT	FROM	TO	SIZE	PUT IN	PULLED OUT
				8-5/8"	400	None

Describe in detail the manner in which the well was plugged, indicating where the mud fluid was placed and the method or methods used in introducing it into the hole. If cement or other plugs were used, state the character of same and depth placed, from feet to feet for each plug set.

Filled with heavy Rotary mud to 390 ft.  
set plug and ran 20 sacks cement through  
drill pipe. Filled with mud to 35 ft. set  
plug and 10 sacks cement at the surface.

1-16-53

(If additional description is necessary, use BACK of this sheet)

Name of Plugging Contractor M. B. Armer  
Address 710 Petroleum Bldg., Wichita 2, Kans.


STATE OF Kansas, COUNTY OF Sedgwick, ss.  
L. C. Sponenberg (employee of owner) or (owner or operator) of the above-described well, being first duly sworn on oath, says: That I have knowledge of the facts, statements, and matters herein contained and the log of the above-described well as filed and that the same are true and correct. So help me God.

(Signature) L. C. Sponenberg  
(Address)

SUBSCRIBED AND SWORN TO before me this 15 day of January, 1953

Lorraine M. Johnson  
Notary Public.

My commission expires Oct. 13, 1956.

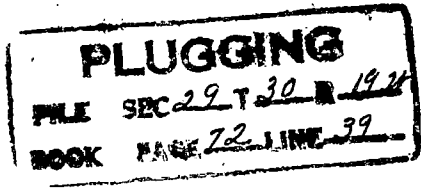

LOG

Company: M. B. Armer  
 Contractor: M. B. Armer (Unit Rig)  
 Drilling Commenced: 12/18/52  
 Drilling Completed: 1/12/53  
 Elevation: 2202 D. F.

Farm: Koehn No. 1  
 Location: C SW SW SW/4  
 Sec. 29-30S-19W  
 Kiowa County, Kans.  
 Casing Record: 8-5/8" casing  
 at 400' with 275 sacks  
 cement.

(figures below indicate bottoms)

Surface Clay & Sand	1140	
Red Bed & Shale	310	
Red Bed, Shale & Shells	1310	
Anhydrite	1340	
Shale & Shells	1415	
Red Bed & Shale	1430	
Shale & Shells	1508	
Shale & Sandy Lime	1585	
Shale & Lime	2240	
Shale & Shells	2385	
Shale & Lime	2510	
Sandy Lime & Shale	2546	
Shale & Lime	4540	
Shale, Lime & Iron	4567	
Shale & Lime	4866	
Shale, Lime & Red Bed	4920	
Lime	4967	
Shale & Lime	5010	
Lime	5065	
Shale & Lime	5200	
R.T.D.	5200	D&A

FORMATION TOPS (R.B. Meas.)

Anhydrite	1310
Brown Lime	4408
Lansing-Kansas City	4418
Mississippi	5037

I hereby certify that this is a true and correct log of the above described well as shown by the drilling reports.

M. B. ARMER

By *L. L. Spounding*

STATE OF KANSAS )  
 ) ss:  
 COUNTY OF SEDGWICK )

Subscribed and sworn to before me, a notary public, in and for said County and State this 15th day of January, 1953.

*Lorraine M. Johnson*

My Commission Expires: Oct. 13, 1956.

**PLUGGING**  
 FILE SEC 29 T 30 R 19W  
 BOOK PAGE 72 LINE 39

FILED  
 NOTARY COMMISSION  
 30115 533  
 DIVISION  
 Kansas