


STATE OF KANSAS
STATE CORPORATION COMMISSION

WELL PLUGGING RECORD

Give All Information Completely
Make Required Affidavit
Mail or Deliver Report to:
Conservation Division
State Corporation Commission
211 No. 1st
Wichita, Kansas

T 19S NORTH R 10W

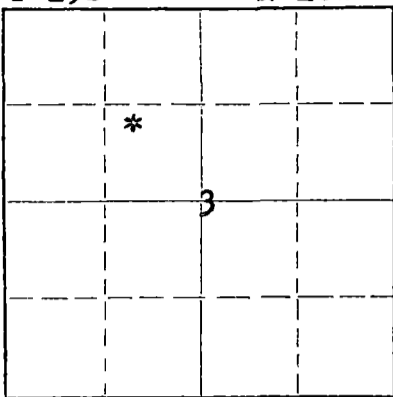

Locate well correctly on above
Section Plat

Rice County. Sec. 3 Twp. 19S Rge. 10W (E) (W)

Location as "NE/CNW/SW" or footage from lines NW SE NW
Lease Owner Carl Lebsack Oil Production Company
Lease Name Zink Well No. 1
Office Address Box 479 - Hays, Kansas
Character of Well (completed as Oil, Gas or Dry Hole) Oil well
Date well completed May 21 19 52
Application for plugging filed February 22 19 56
Application for plugging approved February 23 19 56
Plugging commenced February 22 19 56
Plugging completed February 25 19 56
Reason for abandonment of well or producing formation Depleted.

If a producing well is abandoned, date of last production January 19 56

Was permission obtained from the Conservation Division or its agents before plugging was commenced? Yes

Name of Conservation Agent who supervised plugging of this well Ruel Durkee

Producing formation _____ Depth to top _____ Bottom _____ Total Depth of Well 3303' Feet

Show depth and thickness of all water, oil and gas formations.

OIL, GAS OR WATER RECORDS

CASING RECORD

FORMATION	CONTENT	FROM	TO	SIZE	PUT IN	PULLED OUT
				8-5/8"	145'	None
				5-1/2"	3301'	2719'
				Casing perforated from 3015' to 3020'.		

Describe in detail the manner in which the well was plugged, indicating where the mud fluid was placed and the method or methods used in introducing it into the hole. If cement or other plugs were used, state the character of same and depth placed, from _____ feet to _____ feet for each plug set.

Ran 4 sacks of cement at 3303'. Filled the hole with sand to 3050' and ran 6 sacks of cement. Mudded the hole to 190', set a 10' rock bridge and ran 25 sacks of cement. Mudded the hole to 25', set a 10' rock bridge and ran 5 sacks of cement on top. Plugging completed.

(If additional description is necessary, use BACK of this sheet)

Name of Plugging Contractor West Supply Co., Inc.
Address Chase, Kansas

STATE OF Kansas, COUNTY OF Rice, ss.
Noel J. Knight (employee of owner) or (owner/operator) of the above-described

well, being first duly sworn on oath, says: That I have knowledge of the facts, statements, and matters herein contained and the log of the above-described well as filed and that the same are true and correct. So help me God.

(Signature) Noel J. Knight
Chase, Kansas (Address)

SUBSCRIBED AND SWORN TO before me this 29th day of February 19 56

Edward E. Burns
Notary Public.

My commission expires May 20, 1957

PLUGGING
FILE SEC 3 T 19 R 10W
BOOK PAGE 40 LINE 37

3-1-56

WELL LOG

Carl Lebsack et al, Owner - Zink No. 1
NW 1/4 SE 1/4 NW 1/4 Section 3, Township 19, Range 10W,
Rice County, Kansas

Elevation 1734 DF

Figures indicate bottom of formation
0 to 25 shale

Pipe Record:

8 5/8" set at 145'
5 1/2" set at 3301'

35 sand
125 shale and sand
145 shale and shells
210 shale
438 red bed
466 anhydrite
927 shale and shells
1180 salt
1420 shale and shells
1530 lime and shale
1550 sand
1575 lime
1600 sand
1640 lime
1890 lime and shale
2640 shale and shells
2755 lime and shale
2795 lime
2798 heebner
3270 lime
3296 conglomerate
3303 arbuckle
3303 Total Rotary Depth

Tops: RBM
Heebner 2794
Brown Lime 2918
Lansing 2934
Conglomerate 3255
Arbuckle 3296

Rotary Commenced 5-14-52
Completed 5-21-52

STATE OF KANSAS)
) ss
COUNTY OF BARTON)

I, M. M. Shropshire, Drilling Superintendent of the above-described well,
being first duly sworn on oath, declare: That I have knowledge of the facts,
statements and matters herein contained pertaining to the log of the above-
described well, as filed, and that the same are true and correct.

M. M. Shropshire

Subscribed and Sworn to before me this 22nd day of May, 1952.

George A. Meyer
RECEIVED
FEB 22 1956

My commission expires Feb. 10, 1955.

RECEIVED
STATE COMMISSIONER OF GEOL. & MINING

PLUGGING
FILE SEC 3 T 19 R 10W
BOOK PAGE 40 LINE 37

CONS. DIVISION
STATE OF KANSAS