


STATE OF KANSAS
STATE CORPORATION COMMISSION

Give All Information Completely
Make Required Affidavit
Mail or Deliver Report to:
Conservation Division
State Corporation Commission
212 No. Market
Wichita, Kansas

WELL PLUGGING RECORD

NORTH

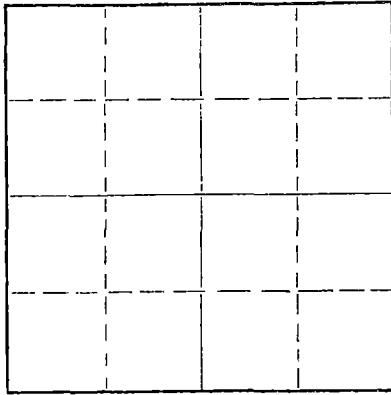

Locate well correctly on above
Section Plat

Rice County. Sec. 36 Twp. 19S Rge. 9 (E) 9 (W)
Location as "NE/CNW/SW" or footage from lines SW NE SW
Lease Owner Keener Oil Company
Lease Name Isal Clary Well No. 1
Office Address 406 Nat'l Bank of Tulsa Bldg., Tulsa, Okla.
Character of Well (completed as Oil, Gas or Dry Hole) Dry Hole
Date well completed December 23, 1968
Application for plugging filed 1968
Application for plugging approved December 23, 1968
Plugging commenced December 23, 1968
Plugging completed December 23, 1968
Reason for abandonment of well or producing formation Dry Hole

If a producing well is abandoned, date of last production 1968
Was permission obtained from the Conservation Division or its agents before plugging was commenced? Yes (Gilbert Toman)

Name of Conservation Agent who supervised plugging of this well _____
Producing formation _____ Depth to top _____ Bottom _____ Total Depth of Well 3400 Feet
Show depth and thickness of all water, oil and gas formations.

OIL, GAS OR WATER RECORDS

CASING RECORD

FORMATION	CONTENT	FROM	TO	SIZE	PUT IN	PULLED OUT
	Surface	0	242'	8-5/8"	12/14/68	-----
	Casing					

Describe in detail the manner in which the well was plugged, indicating where the mud fluid was placed and the method or methods used in introducing it into the hole. If cement or other plugs were used, state the character of same and depth placed, from _____ feet to _____ feet for each plug set.

Heavy Mud from Total Depth to 235 Feet;
Plug and 25 sax Cement thru the Drill
Pipe; Mud to 40 Feet; Plug and 10 sax
Cement to Base of Cellar; 2 sax Cement
in Rat Hole. Job Completed @ 2:30 A.M.
on 12/23/68.


RECEIVED
STATE CORPORATION COMMISSION
JAN 2 1969
CONSERVATION DIVISION
Wichita, Kansas

(If additional description is necessary, use BACK of this sheet)
Name of Plugging Contractor Sage Drilling Co.
Address 500 Bitting Building, Wichita, Kansas 67202

STATE OF KANSAS, COUNTY OF SEDGWICK, ss.
Wayne W. Kahmeyer of Sage Drilling Co. (employee of owner) or (owner or operator) of the above described well, being first duly sworn on oath, says: That I have knowledge of the facts, statements, and matters herein contained and the log of the above-described well as filed and that the same are true and correct. So help me God.

(Signature) Wayne W. Kahmeyer
500 Bitting Building, Wichita, Kansas
(Address)

SUBSCRIBED AND SWORN to before me this 30th day of December, 1968
November 26, 1970.
Louise K. Whitted - Notary Public.

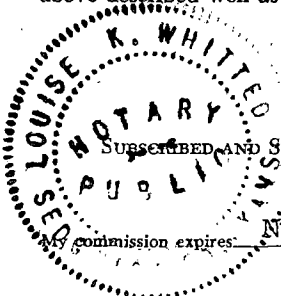

Copy

DRILLERS LOG

ISAL CLARY NO. 1

CASING RECORD:	OPERATOR: Keener Oil Company	DESCRIPTION:
8-5/8" @ 242' w/150 sax cement	CONTRACTOR: Sage Drilling Co.	SW NE SW Sec. 36-19S-9W Rice County, Kansas
TOTAL DEPTH: 3400'	COMMENCED: December 16, 1968	
	COMPLETED: December 23, 1968	

<u>FORMATION</u>	<u>FROM</u>	<u>TO</u>	<u>REMARKS</u>
Surface Soil	0	240	
Shale & Shells	240	1103	
Shale & Lime Streaks	1103	1585	
Shale & Lime	1585	2645	
Lime & Shale	2645	2945	
Lime	2945	2965	
Lime & Shale	2965	3120	
Lime	3120	3400	D&A

I certify that this is a true and correct copy of the above log to the best of my knowledge.

SAGE DRILLING CO., INC.

By Wayne W. Kahmeyer
Wayne W. Kahmeyer



Subscribed and sworn to before me this 30th day of December, 1968.

Louise K. Whitted
Louise K. Whitted, Notary Public

My commission expires:
November 26, 1970.

RECEIVED
STATE CORPORATION COMMISSION
JAN 3 1969
CONSERVATION DIVISION
Wichita, Kansas