

STATE OF KANSAS  
STATE CORPORATION COMMISSION


WELL PLUGGING RECORD

OR  
FORMATION PLUGGING RECORD

Strike out upper line  
when reporting plug-  
ging of formations.

Give All Information Completely  
Make Required Affidavit  
Mail or Deliver Report to:  
Conservation Division  
State Corporation Commission  
800 Biffig Building  
Wichita, Kansas

Rice County. Sec. 36 Twp. 19 Rge. 9 (E) (W)  
Location as "NE $\frac{1}{4}$ NW $\frac{1}{4}$ SW $\frac{1}{4}$ " or footage from lines NW $\frac{1}{4}$  SE $\frac{1}{4}$   
Lease Owner The Drillers Gas Company  
Lease Name J. L. Gray "B" Well No. 1  
Office Address 903 Union National Bldg., Wichita 2, Kansas  
Character of Well (completed as Oil, Gas or Dry Hole) Gas well  
Date well completed April 16 1947  
Application for plugging filed September 1 1948  
Application for plugging approved " 2 1948  
Plugging commenced " 14 1948  
Plugging completed " 16 1948  
Reason for abandonment of well or producing formation Ceased producing gas

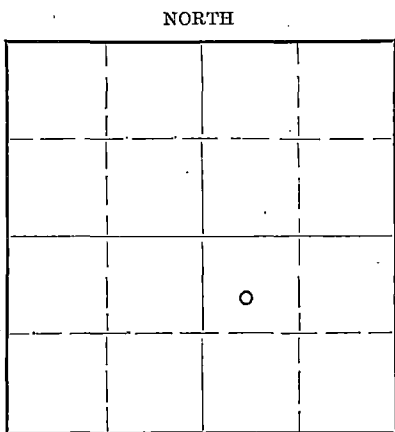

Locate well correctly on above  
Section Plat

If a producing well is abandoned, date of last production August 3 1948  
Was permission obtained from the Conservation Division or its agents before plugging was com-  
menced? Yes

Name of Conservation Agent who supervised plugging of this well Mr. Ruel Durkee  
Producing formation Americus Depth to top 1,968 Bottom 2,117 Total Depth of Well 2,123 Feet  
Show depth and thickness of all water, oil and gas formations. L-W Plug @ 2,071

OIL, GAS OR WATER RECORDS

CASING RECORD

Formation	Content	From	To	Size	Put In	Pulled Out
Tarkio		2,117	2,123	8-5/8" 5-1/2"	135' 2,118'	0 1,412'
Americus		1,968	2,117			

Describe in detail the manner in which the well was plugged, indicating where the mud fluid was placed and the method or methods used in introducing it into the hole. If cement or other plugs were used, state the character of same and depth placed, from \_\_\_\_\_ feet to \_\_\_\_\_ feet for each plug set.

Mix and pump 100 sacks of mud by Globe Cementing Company

Shot and pulled 1,412' pipe

Mudded hole to 150'

Dumped 15 sacks cement @ 150'

Finished mudding hole

Put five sacks cement at top of surface pipe

(If additional description is necessary, use BACK of this sheet)

Correspondence regarding this well should be addressed to The Drillers Gas Company  
Address 903 Union National Bank Building, Wichita 2, Kansas

STATE OF KANSAS, COUNTY OF SEDGWICK, ss.  
M. R. Schwartzkopf (employee of owner) of the above-described well,  
being first duly sworn on oath, says: That I have knowledge of the facts, statements, and matters herein contained and the log of the above-described well as filed and that the same are true and correct. So help me God.


(Signature) *M. R. Schwartzkopf*  
903 Union National Bank Building  
Wichita 2, Kansas  
(Address)

SUBSCRIBED AND SWORN to before me this 14th day of October, 1948

*Bertie L. Wilson*

Notary Public.

My commission expires August 13, 1951

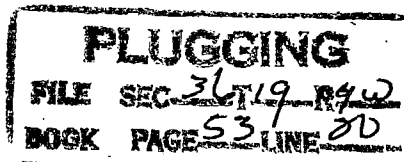

10-16-48

WELL LOG BUREAU - KANSAS GEOLOGICAL SOCIETY  
 2 Union National Bk. Bldg., Wichita, Kansas

Company - THE DRILLER'S GAS COMPANY  
 Farm - Gray "B" No. 1

SEC. 36 T. 19 R. 9W  
 CNW SE

Total Depth. 2125'  
 Comm. 4-4-47 Comp. 4-16-47  
 Shot or Treated. Acid. w/1000 gals.  
 Contractor.  
 Issued. 5-24-47

County. Rice  
 KANSAS



CASING:  
 8-5/8" 135' Cem. w/100 sx  
 5-1/2" 2120' Cem. w/100 sx

Elevation. \_\_\_\_\_

Production. Gauge 3,970,000 Gas  
 Per Day

Figures Indicate Bottom of Formations.

clay	0-50
sand	60
shale	115
shale & shells	138
red rock & shale	185
shale & shells	200
red rock & shale	280
lime	300
shale & shells	810
salt	1080
lime & shale	2050
shale	2100
shale & lime	2120
lime	2125
Total Depth	

Tops:	
Neva	1848
Foraker	1898
Americus	1966
Tarkio	2117

PLUGGING  
 ALL SEC 36 T 19 R 9W  
 LOCK RICE 53 LINE 20