

WELL PLUGGING RECORD


STATE OF KANSAS
STATE CORPORATION COMMISSION

FORMATION PLUGGING RECORD

Give All Information Completely
Make Required Affidavit
Mail or Deliver Report to:
Conservation Division
State Corporation Commission
300 Bittling P...
Wichita, Kan...

Strike out upper line
when reporting plug-
ging off formations.

Rice County. Sec. 36 Twp. 19 Rge. 9 (W)
Location as "NE 1/4 NW 1/4 SW 1/4" or footage from lines SE 1/4 NW 1/4
Lease Owner The Drillers Gas Company
Lease Name Daenzer Well No. 1
Office Address 903 Union National Bldg., Wichita 2, Kansas
Character of Well (completed as Oil, Gas or Dry Hole) Gas well
Date well completed May 11 19.47
Application for plugging filed September 1 19.48
Application for plugging approved " 2 19.48
Plugging commenced " 20 19.48
Plugging completed " 22 19.48
Reason for abandonment of well or producing formation Ceased producing gas

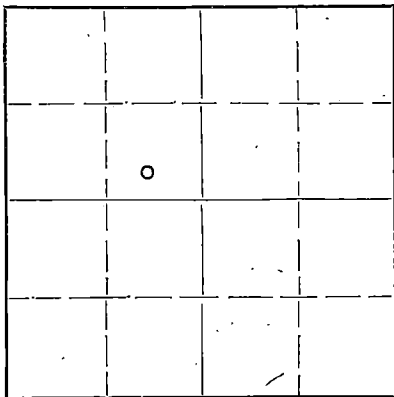

Locate well correctly on above
Section Plat

If a producing well is abandoned, date of last production August 3 19.48
Was permission obtained from the Conservation Division or its agents before plugging was com-
menced? Yes

Name of Conservation Agent who supervised plugging of this well Mr. Ruel Durkee
Producing formation Americus Depth to top 1,971 Bottom 2,123 Total Depth of Well 2,127 Feet
Show depth and thickness of all water, oil and gas formations. L-W Plug 2,085

OIL, GAS OR WATER RECORDS

CASING RECORD

Formation	Content	From	To	Size	Put In	Pulled Out
Tarkio		2,123	2,127	8-5/8"	120'	0
Americus		1,971	2,123	5-1/2"	2,124'	1,304'

Describe in detail the manner in which the well was plugged, indicating where the mud fluid was placed and the method or methods used in introducing it into the hole. If cement or other plugs were used, state the character of same and depth placed, from... feet to... feet for each plug set.

Mix and pump 100 sacks mud by Globe Cementing Co.

Shot and pulled 1,304' pipe

Mud hole to 150'

Dump 15 sacks cement @ 150'

Finish mudding hole

Five sacks cement at top of surface pipe

(If additional description is necessary, use BACK of this sheet)

Correspondence regarding this well should be addressed to The Drillers Gas Company
Address 903 Union National Bank Building, Wichita 2, Kansas


STATE OF KANSAS, COUNTY OF SEDGWICK, ss.
M. R. Schwartzkopf (employee of owner) of the above-described well,
being first duly sworn on oath, says: That I have knowledge of the facts, statements, and matters herein contained and the log of the above-described well as filed and that the same are true and correct. So help me God.

(Signature) M. R. Schwartzkopf
903 Union National Bank Bldg.
Wichita 2, Kansas
(Address)

SUBSCRIBED AND SWORN to before me this 14th day of October, 1948

Bertha L. Wilson
Notary Public.

My commission expires August 13, 1951

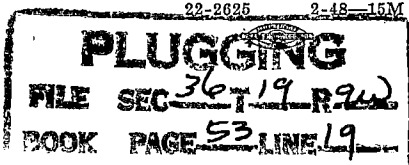

10-16-48

WELL LOG BUREAU — KANSAS GEOLOGICAL SOCIETY
412 Union National Bk. Bldg., Wichita, Kansas

Company - DRILLERS GAS CO.
Farm - Daenzer No. 1

SEC. 36 T. 19 R. 9W
CSE NW

Total Depth. 2130'
Comm. 5-1-47 Comp. 5-11-47
Shot or Treated.
Contractor.
Issued. 5-31-47

County. Rice

KANSAS



Elevation. _____

Production. 648,000 Gas Daily

CASING:

8 5/8" 120' cem. w/100 sx.
5 1/2" 2126' cem. w.100 sx.

Figures Indicate Bottom of Formations.

soil	0-6
shale	70
sand	80
shale & shells	127
shale	188
red rock	219
shale & shells	280
shale & lime	300
lime	325
shale & shells	825
shale & salt	1080
shale & lime	1400
lime	1540
lime & shale	2125
Tarkio Lime	2130
Total Depth	

Tops:
Americus 1971
Tarkio 2123

Production:
648,000 Cu.Ft.Gas Daily.

PLUGGING
FILE SEC 36 T. 19 R. 9W
BOOK PAGE 53 LINE 19

