


Give All Information Completely  
Make Required Affidavit  
Mail or Deliver Report to:  
Conservation Division  
State Corporation Commission  
212 North Market, Insurance Bldg.  
Wichita, Kansas

**WELL PLUGGING RECORD**

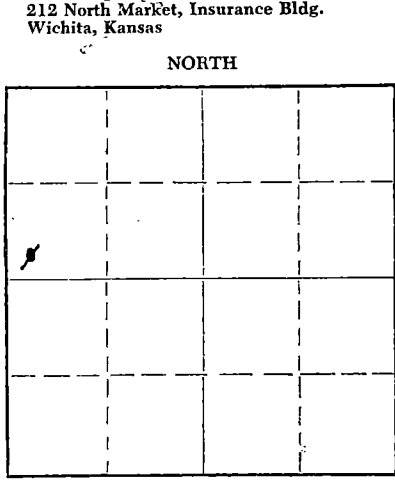

Barton County, Sec. 36 Twp. 20S Rge. (E) 12W(W)  
Location as "NE/CNW/SW" or footage from lines SW/4 SW/4 NW/4  
Lease Owner Birmingham-Bartlett Drilling Co., et al  
Lease Name Panning "A" Well No. 3  
Office Address 300 Kaufman Building, Wichita 2, Kansas  
Character of Well (completed as Oil, Gas or Dry Hole) Oil Well  
Date well completed May 27, 1955  
Application for plugging filed February 27, 1962  
Application for plugging approved March 2, 1962  
Plugging commenced 3-14 1962  
Plugging completed 3-22 1962  
Reason for abandonment of well or producing formation Well no longer considered a commercial producer

If a producing well is abandoned, date of last production February 16, 1962  
Was permission obtained from the Conservation Division or its agents before plugging was commenced? Yes

Name of Conservation Agent who supervised plugging of this well Donald Truan  
Producing formation 3396' Depth to top Bottom Total Depth of Well 3459 Feet  
Show depth and thickness of all water, oil and gas formations.

**OIL, GAS OR WATER RECORDS**

**CASING RECORD**

FORMATION	CONTENT	FROM	TO	SIZE	PUT IN	PULLED OUT
		0	235	8-5/8"	235'	None
		0	3403	5-1/2"	3403'	2028

Describe in detail the manner in which the well was plugged, indicating where the mud fluid was placed and the method or methods used in introducing it into the hole. If cement or other plugs were used, state the character of same and depth placed, from \_\_\_\_\_ feet to \_\_\_\_\_ feet for each plug set.

*Hand back from 3459 to 3380 - Dump 4 sack Cement  
Pull pipe to 460 ft - Pump 10 sack mud - Pull pipe to 400 ft  
Pump 20 sack Cement - Pull pipe to 190 ft - Pump 20 sack  
Cement - Pull pipe - mud table w/ chunk mud to 30 ft  
Dump 10 sack Cement.*

STATE CORPORATION COMMISSION  
APR 10 1962  
CONSERVATION DIVISION  
Wichita, Kansas

4-12-62

Name of Plugging Contractor *Ralph Comstock Pipe Pulling Co. - Permit # 490*  
Address *Stafford Kansas*

STATE OF KANSAS COUNTY OF SEDGWICK  
Chas. H. Keevert, Production Supt. of Birmingham-Bartlett Drilling Co., operator  
(employee of owner) or (owner or operator) of the above-described well, being first duly sworn on oath, says: That I have knowledge of the facts, statements, and matters herein contained and the log of the above-described well as filed and that the same are true and correct. So help me God.

(Signature) *Chas H Keevert*  
Wilson Rd., Rt. 1, Hutchinson, Kansas  
(Address)

SUBSCRIBED AND SWORN to before me this 11th day of April, 1962.

*Vivian F. Yinger*  
Vivian F. Yinger, Notary Public.

My commission expires November 29, 1962.

PAINING NO. 3 WELL

LOCATION: In SW $\frac{1}{4}$  SW $\frac{1}{4}$  NW $\frac{1}{4}$  Sec. 36-208-12W  
Barton County, Kansas

SPUDED: 5-15-55

COMPLETED: 5-23-55

OWNER, OPERATOR  
and CONTRACTOR: Birmingham-Bartlett Drilling Co.  
300 Kaufman Building  
Wichita 2, Kansas

SURFACE CASING: 8-5/8" 24# casing cemented at 235'  
with 200 sacks cement and 3 c.c.

OIL STRING: 5-1/2" 14# J-55 Rgs 2 & 3 Sals.  
casing set at 3403' with 100 sacks cement

LOG

(Figures indicate bottom of formation)

0 -	150	Sand & Clay
	235	Shale & Shells
	500	Red Bed & Shells
	595	Red Bed
	620	Anhydrite
	1410	Shale & Shells
	2785	Lime & Shale
	2975	Lime
	2985	Lime & Shale
	3060	Lime
	3143	Lime & Shale
	3407	Lime
	3407	Rotary Total Depth

**RECEIVED**

STATE CORPORATION COMMISSION

FEB 29 1962

CONSERVATION DIVISION  
Wichita, Kansas

The undersigned, Richard Hindery, one of the partners of Birmingham-Bartlett Drilling Co., hereby certifies that the above is a true and correct log of the formations encountered in drilling the Paining No. 3 Well as shown in the daily drilling reports.

BIRMINGHAM-BARTLETT DRILLING CO.

By Richard Hindery

Subscribed and sworn to before  
me this 25th day of May, 1955.

Vivian F. Ginger  
Notary Public

My commission expires: November 29, 1958.