

STATE OF KANSAS  
STATE CORPORATION COMMISSION  
200 Colorado Derby Bldg.  
Wichita, Kansas 67202

Form CP-4  
Rev. 12-15-80

WELL PLUGGING RECORD

Give All Information Completely  
Make Required Affidavit

COUNTY Barton SEC. 33 TWP. 20S RGE. 14W E/W  
Location as in quarters or footage from lines:  
SE NW SE


Locate Well  
correctly on above  
Section Platt.

Lease Owner National Cooperative Refinery Association  
Lease Name McGreevy B-2 Well No. \_\_\_\_\_  
Office Address Box 6 Great Bend, Kansas 67530  
Character of Well (Completed as Oil, Gas or Dry Hole): \_\_\_\_\_  
Date Well Completed \_\_\_\_\_  
Application for plugging filed \_\_\_\_\_  
Plugging commenced 2-26-82  
Plugging completed 3-3-82  
Reason for abandonment of well or producing formation \_\_\_\_\_

Depleted  
Was permission obtained from the Conservation Division or it's  
Agent's before plugging was commenced? Yes

Name of Conservation Agent who supervised plugging of this well J.H. Metz  
Producing formation \_\_\_\_\_ Depth to top \_\_\_\_\_ bottom T.D. 3555'

Show depth and thickness of all water, oil and gas formations.

OIL, GAS OR WATER RECORDS

Casing Record

Formation	Content	From	To	Size	Put in	Pulled Out
				8-5/8"	830'	none
				5-1/2"	3547'	2483'

Describe in detail the manner in which the well was plugged, indicating where the mud fluid was placed and the method or methods used in introducing it into the hold. If cement or other plugs were used, state the character of same and depth placed, from \_\_\_\_\_ feet to \_\_\_\_\_ feet for each plug set.

Plugged off bottom with sand to 3250' and ran 5 sacks cement. Pumped 70 barrels salt gel between 8-5/8" and 5-1/2" casing. Shot casing @2830', 2770', 2705', 2610', and 2485'. Pulled a total of 78 joints of pipe. Plugged well with 5 sacks hulls, 25 sacks gel, released plug and displaced with 140 sacks 50/50 pos, 4% gel, 3% cc. Plugging Complete.

(If additional description is necessary, use BACK of this sheet.)  
Name of Plugging Contractor Kelso Casing Pulling

RECEIVED  
STATE CORPORATION COMMISSION

3-12-82 MAR 12 1982


STATE OF Kansas COUNTY OF Rice, ss.

R. Darrell Kelso (employee of owner) or (owner or operator) of the above-described well, being first duly sworn on oath, says: That I have knowledge of the facts, statements, and matters herein contained and the log of the above-described well as filed and that the same are true and correct. So help me God.

(Signature) R. Darrell Kelso  
Box 176 Chase, Kansas 67524  
(Address)

SUBSCRIBED AND SWORN TO before me this 10th day of March, 19 82

My Commission expires:

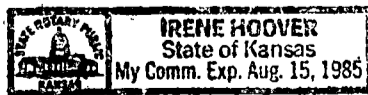

Irene Hoover  
Notary Public.

WELL LOG BUREAU—KANSAS GEOLOGICAL SOCIETY  
503 East Murdock, Wichita, Kansas

15.009.19044.0000


**COPY**

Company- TOM PALMER OIL CORP.  
Farm- McGreevy "B" No. 2

SEC. 33 T. 20 R. 14W  
SE NW SE

Total Depth. 3552 $\frac{1}{2}$   
Comm. 9-26-51 Comp. 10-18-51  
Shot or Treated.  
Contractor. Palmer  
Issued. 11-17-51

County Barton  
KANSAS

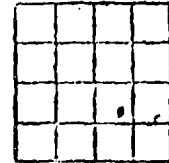

CASING:

6 5/8" 830' cem. w/475 sx.  
5 1/2" 3547 $\frac{1}{2}$  cem. w/80 sx.

Elevation. 1917 R.B.

Production. 1616 bbls. echo.

Figures Indicate Bottom of Formations.

sand, shale & shells	635
shale & shells	830
anhyd.	850
red bed & shale	1050
shale & shells	1710
lime & shale	2990
lime	3530
congl.	3547
Arb. lime	3549 RTD
Arb. lime	3552 $\frac{1}{2}$
Total Depth	

**K. G. S. LIBRARY**

Tops: R.B.	
Heebner	3178
Brown lime	3280
Lansing	3290
Sdy Congl.	3532
Simpson	traco
Arb.	3547

Az. w/1000 gals. on 10-13-51. Az. w/  
2000 gals. on 10-14-51. Az. w/3000 gals.  
on 10-16-51.

RECEIVED  
STATE CORPORATION COMMISSION  
AUG 30 1981

CONSERVATION DIVISION  
Wichita, Kansas

RECEIVED  
STATE CORPORATION COMMISSION  
AUG 30 1981

CONSERVATION DIVISION  
Wichita, Kansas