

Give All Information Completely
Make Required Affidavit
Mail or Deliver Report to:
Conservation Division
State Corporation Commission
211 No. Broadway
Wichita, Kansas

WELL PLUGGING RECORD

Barton County. Sec. 33 Twp. 20S Rge. (#) 11 (W)

Location as "NE/CNW%SW%" or footage from lines SW NE NE

Lease Owner Sunray DX Oil Company

Lease Name McGreevy Well No. 4

Office Address P. O. Box 729, Great Bend, Kansas

Character of Well (completed as Oil, Gas or Dry Hole) Dry hole

Date well completed 8-11 1963

Application for plugging filed 8-11 1963

Application for plugging approved 8-15 1963

Plugging commenced 8-11 1963


Plugging completed 8-11 1963

Reason for abandonment of well or producing formation

No commercial oil found

If a producing well is abandoned, date of last production ---- 19---

Was permission obtained from the Conservation Division or its agents before plugging was commenced? Yes

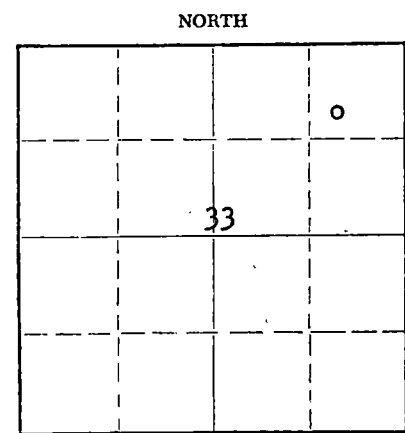

Locate well correctly on above Section Plat

Name of Conservation Agent who supervised plugging of this well Gilbert Leiker

Producing formation _____ Depth to top _____ Bottom _____ Total Depth of Well 3620 Feet

Show depth and thickness of all water, oil and gas formations.

OIL, GAS OR WATER RECORDS

CASING RECORD

FORMATION	CONTENT	FROM	TO	SIZE	PUT IN	PULLED OUT
				8-5/8"	859'	None

Describe in detail the manner in which the well was plugged, indicating where the mud fluid was placed and the method or methods used in introducing it into the hole. If cement or other plugs were used, state the character of same and depth placed, from _____ feet to _____ feet for each plug set.

Set wooden plug at 365' with 25 sacks cement on top of plug, 1/2 sack cotton seed hull and wooden plug set at 40' with 10 sacks cement on top of plug. Capped rat hole and mouse hole with 5 sacks cement. All intervals between plugs filled with 10.3# mud ladden fluid. Job complete 7:30 am 8-11-63.

RECEIVED
STATE CORPORATION COMMISSION

AUG 26 1963
8-26-63
CONSERVATION DIVISION
Wichita, Kansas

(If additional description is necessary, use BACK of this sheet)

Name of Plugging Contractor Stickle Drilling Company

Address Tulsa, Oklahoma

STATE OF KANSAS, COUNTY OF BARTON, ss.

C. H. PETERSON

(employee of owner) or (owner or operator) of the above-described

well, being first duly sworn on oath, says: That I have knowledge of the facts, statements, and matters herein contained and the log of the above-described well as filed and that the same are true and correct. So help me God.

(Signature) C. H. Peterson

C. H. Peterson, District Engineer

P. O. Box 729, Great Bend, Kansas

(Address)

SUBSCRIBED AND SWORN TO before me this 23rd day of August, 1963

My commission expires February 22, 1967

D. L. Jackson

Notary Public.



Sunray DX Oil Company
Tulsa, Oklahoma

Tulsa, Oklahoma
August 19, 1963

Contractor: Stickle Drilling Company
Date Commenced: August 4, 1963
Date Completed: August 13, 1963

McGreevy No. 4
SW NE NE Sec. 33-20S-14W
Barton County, Kansas

DRILLER'S LOG

Depth Figures Indicate Base of Formation:

Sand	180
Shale	310
Sand and red bed	550
Red bed	850
Anhydrite and shale	870
Shale	1875
Lime and shale	2110
Shale and lime	2289
Lime and shale	2436
Shale and lime	2911
Lime and shale	3035
Lime	3140
Lime and shale	3205
Shale and lime	3345
Lime and shale	3390
Lime	3620 TD


RECEIVED
STATE CORPORATION COMMISSION

AUG 26 1963

CONSERVATION DIVISION
Wichita, Kansas

I, Fred E. Stickle, hereby certify the above to be a true and complete Driller's Log of Sunray DX Oil Company's McGreevy No. 4 Well, SW NE NE of Section 33-20S-14W, Barton County, Kansas.


FRED E. STICKLE


Notary Public

My Commission Expires January 11, 1967