


STATE OF KANSAS
 STATE CORPORATION COMMISSION
 Give All Information Completely
 Make Required Affidavit
 Mail or Deliver Report to:
 Conservation Division
 State Corporation Commission
 P. O. Box 17027
 Wichita, Kansas 67217
 NORTH

WELL PLUGGING RECORD

Barton County, Sec. 33 Twp. 20 Rge. 14 (E) W (W)
 Location as "NE/CNWxSWx" or footage from lines SE SE SW
 Lease Owner National Cooperative Refinery Assn.
 Lease Name McGreevy "A" Well No. # 1
 Office Address P. O. Box 6 ; Great Bend, Kansas 67530
 Character of Well (completed as Oil, Gas or Dry Hole) Oil
 Date well completed May 19 51
 Application for plugging filed February 19 72
 Application for plugging approved February 19 72
 Plugging commenced February 24 19 72
 Plugging completed March 3 1972 19 72
 Reason for abandonment of well or producing formation No longer economic

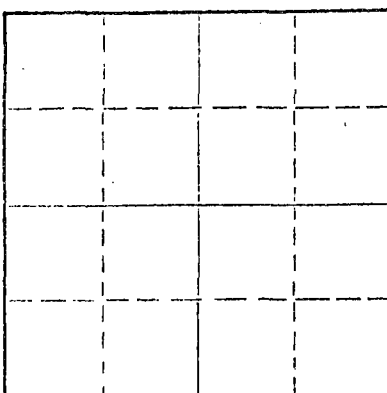

Locate well correctly on above Section Plat

If a producing well is abandoned, date of last production January 19 68
 Was permission obtained from the Conservation Division or its agents before plugging was commenced? Yes

Name of Conservation Agent who supervised plugging of this well Don Truan
 Producing formation Arb. & K. C. Depth to top 3281' Bottom 3553' Total Depth of Well 3553' Feet
 Show depth and thickness of all water, oil and gas formations.

OIL, GAS OR WATER RECORDS

CASING RECORD

FORMATION	CONTENT	FROM	TO	SIZE	PUT IN	PULLED OUT
	STATE CORPORATION COMMISSION			8 5/8"	828	None
	MAR 8 1972			5 1/2"	3547	2830
	CONSERVATION DIVISION					
	Wichita, Kansas					

Describe in detail the manner in which the well was plugged, indicating where the mud fluid was placed and the method or methods used in introducing it into the hole. If cement or other plugs were used, state the character of same and depth placed, from _____ feet to _____ feet for each plug set.

February 24, 1972 Plugged off bottom. Dumped sand to 3200'. Mixed and dumped 5 sx of cement.

March 3, 1972 Plugged off top. Set 20' rock bridge from 350' to 370'. Filled 8 5/8" surface casing from 350' to base of cellar with 3000 lb. P.S.I. ready - mix concrete.


(If additional description is necessary, use BACK of this sheet)

Name of Plugging Contractor RUSS CASING PULLING, INC.
 Address P. O. Box 1082 ; Great Bend, Kansas 67530

STATE OF Kansas, COUNTY OF Barton, ss.
Russell D. Sullivan (Notary Public) or (operator) of the above-described

well, being first duly sworn on oath, says: That I have knowledge of the facts, statements, and matters herein contained and the log of the above-described well as filed and that the same are true and correct. So help me God.

(Signature) Russell D. Sullivan
 (Address) _____

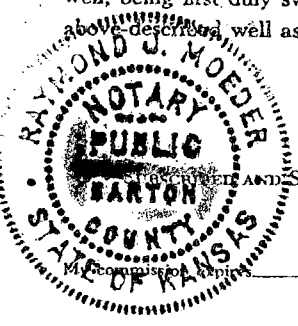

SWORN to before me this 7 day of MARCH, 19 72

10-20-75
Raymond J. Moeder
 Notary Public.