


STATE OF KANSAS
STATE CORPORATION COMMISSION

Give All Information Completely
Make Required Affidavit
Mail or Deliver Report to:
Conservation Division
State Corporation Commission
P. O. Box 17027
Wichita, Kansas 67217
NORTH

WELL PLUGGING RECORD

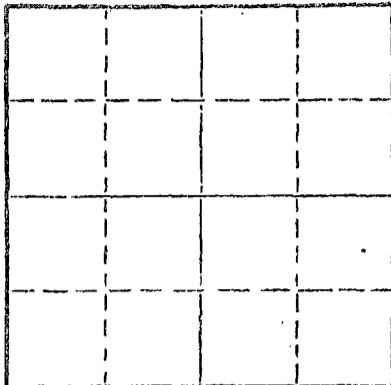

Locate well correctly on above
Section Plat

Pawnee County, Sec. 8 Twp. 23 Rge. 17 (E) (WX)
Location as "NE/CNW/SW" or footage from lines C SL NW
Lease Owner A. L. Abercrombie, Inc.
Lease Name Clark Well No. #6
Office Address 801 Union Center Bldg. Wichita, Kansas
Character of Well (completed as Oil, Gas or Dry Hole)
Date well completed 19
Application for plugging filed 19
Application for plugging approved 19
Plugging commenced 12-16-73 19
Plugging completed 12-20-73 19
Reason for abandonment of well or producing formation

If a producing well is abandoned, date of last production 19
Was permission obtained from the Conservation Division or its agents before plugging was commenced?

Name of Conservation Agent who supervised plugging of this well Leo Massey
Producing formation Depth to top Bottom Total Depth of Well 4334' Feet
Show depth and thickness of all water, oil and gas formations.

OIL, GAS OR WATER RECORDS

CASING RECORD

| FORMATION | CONTENT | FROM | TO | SIZE | PUT IN | PULLED OUT |
|-----------|---------|------|----|--------|--------|------------|
| | | | | 5 1/2" | 4333' | 2757.92' |
| | | | | 8 5/8" | 214' | |
| | | | | | | |
| | | | | | | |
| | | | | | | |
| | | | | | | |
| | | | | | | |
| | | | | | | |

Describe in detail the manner in which the well was plugged, indicating where the mud fluid was placed and the method or methods used in introducing it into the hole. If cement or other plugs were used, state the character of same and depth placed, from feet to feet for each plug set.

Made bottom hole plug back with sand to 4150'. Mixed and ran 4 sacks cement thru dump bailer.
Plugged well with 3 sacks hulls - 20 sacks gel and 100 sacks cement plus 2% gel to base of cellar.


RECEIVED
STATE CORPORATION COMMISSION
DEC 28 1973
CONSERVATION DIVISION
Wichita, Kansas

Name of Plugging Contractor Southwest Casing Pulling Co.
Address Box 364 Great Bend, Kansas

STATE OF Kansas, COUNTY OF Barton, ss.
Southwest Casing Pulling Co. (employee of owner) or (owner or operator) of the above-described well, being first duly sworn on oath, says: That I have knowledge of the facts, statements, and matters herein contained and the log of the above-described well as filed and that the same are true and correct. So help me God.

(Signature) W. C. Spencer Sec.
Box 364 Great Bend, Kansas
(Address)

Subscribed and sworn to before me this 27 day of December, 1973.
My commission expires October 1976
Sidney D. Miller
Notary Public.

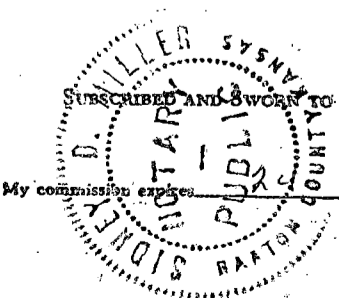

15-145-00835 0000

WELL LOG.

WELCH & OLSSON DRILLING COMPANY, INC. Elevation: 2085 R.B.
 CONTRACTOR: WELCH & OLSSON DRILLING COMPANY, INC. Comm. Drlg. 11-24-55
 CLARK #6 Comp. Drlg: 12-10-55
 CSL NW/4 of Sec. 8-23-17W, Pawnee County, Kansas Production: 011 W811

CASING RECORD.

Set 215' of 8 5/8" with 175 sacks cement.

(Figures indicated bottom of formations.)

| <u>FORMATIONS</u> | <u>DEPTHS</u> | <u>FORMATION TOPS</u> | |
|----------------------|---------------|-----------------------|--------------|
| Shale: | 410 | Hoebner: | 3637 (-1552) |
| Shale and Red Bed: | 580 | Brown Lime: | 3743 (-1658) |
| Sand: | 600 | Lansing-Kansas City: | 3750 (-1665) |
| Red Bed & Shale: | 1119 | Shaley-Conglomerate: | 4175 (-2090) |
| Shale & Shells: | 1900 | Cherty Conglomerate: | 4197 (-2112) |
| Shale & Lime | 3660 | Misener Sand: | 4284 (-2199) |
| Lime: | 4185 | Viola: | 4310 (-2225) |
| Shaley Conglomerate: | 4200 | | |
| Lime & Chert: | 4254 | | |
| Chert: | 4280 | | |
| Sand: | 4298 | | |
| Chert & Shale: | 4334 T.D. | | |

RECEIVED
 STATE CORPORATION COMMISSION
 NOV 13 1973
 CONSERVATION DIVISION
 Wichita, Kansas

STATE OF KANSAS,)
) SS:
 SEDGWICK COUNTY)

I hereby certify that the above is a true and correct copy of Drillers Log of well drilled in the center of the South Half of the South Half of the Northwest Quarter of Section 8-23-17, Pawnee County, Kansas.

WELCH & OLSSON DRILLING COMPANY, INC.
 BY _____
 R. E. WELCH

Subscribed and sworn to before me this 15th day of December, 1955.

Notary Public.

My commission expires:
June 12, 1959