

15-149-01100-0001


STATE OF KANSAS
STATE CORPORATION COMMISSION

Form CP-4

WELL PLUGGING RECORD

Give All Information Completely
Make Required Affidavit
Mail or Deliver Report to:
Conservation Division
State Corporation Commission
212 No. Market
Wichita, Kansas

NORTH

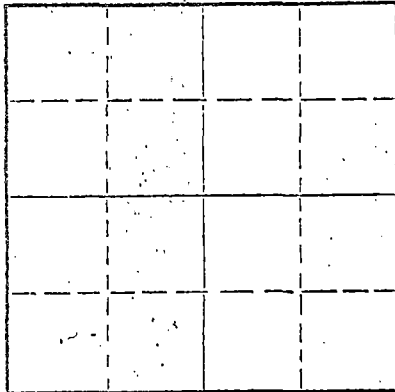

Locate well correctly on above
Section Plat

Pawnee County. Sec. 7 Twp. 23 Rge. 17 (E) (W) X
Location as "NE/CNW/SW" or footage from lines 1650 NL 330' EL. NW/4
Lease Owner Bovaird Supply Co.
Lease Name Godfrey Well No. #3
Office Address Box 48 Great Bend, Kansas
Character of Well (completed as Oil, Gas or Dry Hole) _____
Date well completed _____ 19____
Application for plugging filed 7-20-72 19____
Application for plugging approved _____ 19____
Plugging commenced 8-5-72 19____
Plugging completed 8-11-72 19____
Reason for abandonment of well or producing formation _____

If a producing well is abandoned, date of last production _____ 19____
Was permission obtained from the Conservation Division or its agents before plugging was commenced? _____

Name of Conservation Agent who supervised plugging of this well Donald Truan
Producing formation _____ Depth to top _____ Bottom _____ Total Depth of Well 4311' Feet
Show depth and thickness of all water, oil and gas formations.

OIL, GAS OR WATER RECORDS

CASING RECORD

FORMATION	CONTENT	FROM	TO	SIZE	PUT IN	PULLED OUT
				5 1/2"	4309'	3135.14'
				8 5/8"	220'	

Describe in detail the manner in which the well was plugged, indicating where the mud fluid was placed and the method or methods used in introducing it into the hole. If cement or other plugs were used, state the character of same and depth placed, from _____ feet to _____ feet for each plug set.

Made bottom hole plug back with sand to 4200' Mixed and ran 5 sacks cement thru dump bailer.

Squeezed hole with 4 sacks hulls - 25 sacks gel. Released plug - 1 sacks hulls, 100 sacks common cement with 2% C.C.


RECEIVED
STATE CORPORATION COMMISSION
AUG 14 1972
CONSERVATION DIVISION
Wichita, Kansas

(If additional description is necessary, use BACK of this sheet)
Name of Plugging Contractor Southwest Casing Pulling Co.
Address Box 364 Great Bend, Kansas

STATE OF Kansas, COUNTY OF Barton, ss.
Southwest Casing Pulling Co. (employee of owner) or (owner or operator) of the above-described well, being first duly sworn on oath, says: That I have knowledge of the facts, statements, and matters herein contained and the log of the above-described well as filed, and that the same are true and correct. So help me God.

(Signature) W. C. Spencer Sec.
Box 364 Great Bend, Kansas
(Address)

Subscribed AND Sworn to before me this 12 day of August, 1972

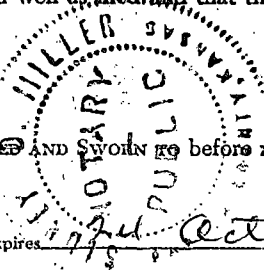

Sidney D. Miller
Notary Public.

Commission expires October 1972

15-145-01100-00-01

DRILLER'S LOG

COMPANY: Hilton Drilling Company, Inc. LOCATION: 1,650' NL, 330' EL,
 NW/4 Sec. 7-23S-17W
 Pawnee County, Kansas
 CONTRACTOR: Hilton Drilling Company, Inc.
 FARM NAME: Godfrey No. 3 ELEVATION: 2072' D. F.
 COMMENCED: March 28, 1956 CASING USED: 8-5/8" @ 220' w/ 200 spcs
 5-1/2" @ 4309' w/ 150 spcs
 COMPLETED: April 10, 1956

Surface Clay, sand and Shale	220
Shale	325
Shale and Sand	595
Dakota Sand	640
Shale, Red Bed and Sand	1120
Anhydrite	1140
Shale and Shells	2070
Shale and Lime	2315
Lime	2550
Lime and Shale	3020
Shale	3155
Lime and Shale	3415
Lime	3532
Lime and Shale	3595
Lime	3733
Shale and Lime	3796
Lime	4230
Chert	4240
Lime and Chert	4311
Total Depth	4311

RECEIVED
 STATE CORPORATION COMMISSION
 JUL 21 1972
 CONSERVATION DIVISION
 Wichita, Kansas

STATE OF KANSAS)
) SS
 COUNTY OF BARTON)

I, the undersigned, being duly sworn on oath, state that the above statement and log are true and a correct record and log of the well drilled at the location above described.

HILTON DRILLING COMPANY, INC.

Henry Peacock
 Henry Peacock, Secretary

Subscribed and sworn to before me this 11th day of April, 1956.

Mildred Hobbie
 Notary Public

MILDRED HOBBIIE
 MY COMMISSION EXPIRES MARCH 6, 1958

My Commission expires _____