

CARD MUST BE TYPED

State of Kansas
NOTICE OF INTENTION TO DRILL
(see rules on reverse side)

CARD MUST BE SIGNED

Starting Date: 5 24 85
month day year

API Number 15- 097-21,145-0000

OPERATOR: License # KCC #4243

C NW NW Sec 23 Twp 30 S, Rge 20
(location) East West

Name Cross Bar Petroleum, Inc.

Address P. O. Box 20080

City/State/Zip Wichita, KS 67208

Contact Person Albert Brensing

Phone (316)-683-5956 or (316)-548-2233

4620 Ft North from Southeast Corner of Section

4620 Ft West from Southeast Corner of Section

(Note: Locate well on Section Plat on reverse side)

CONTRACTOR: License # 5302

Name Red Tiger Drilling Co.

City/State Wichita, Kansas 67202

Nearest lease or unit boundary line 660 feet.

County Kiowa

Lease Name Brensing #1 Well# 1A

Well Drilled For: Well Class: Type Equipment:

- | | | | |
|---|-------------------------------|---|--|
| <input checked="" type="checkbox"/> Oil | <input type="checkbox"/> Swd | <input type="checkbox"/> Infield | <input checked="" type="checkbox"/> Mud Rotary |
| <input type="checkbox"/> Gas | <input type="checkbox"/> Inj | <input type="checkbox"/> Pool Ext. | <input type="checkbox"/> Air Rotary |
| <input type="checkbox"/> OWWO | <input type="checkbox"/> Expl | <input checked="" type="checkbox"/> Wildcat | <input type="checkbox"/> Cable |

Domestic well within 330 feet : yes no

Municipal well within one mile : yes no

If OWWO: old well info as follows:

Depth to Bottom of fresh water 200 mhc feet

Lowest usable water formation

Depth to Bottom of usable water 220 mhc feet

Surface pipe by Alternate : 1 2

Surface pipe to be set 600 feet

Conductor pipe if any required

Ground surface elevation 2241 feet MSL

This Authorization Expires 11-22-85

Approved By 5-22-85 R

I certify that we will comply with K.S.A. 55-101, et seq., plus eventually plugging hole to K.C.C. specifications.

Date 5/22/85 Signature of Operator or Agent Albert Brensing

Title President

mhc/udhe 5-22-85

RECEIVED
STATE CORPORATION COMMISSION

Must be filed with the K.C.C. five (5) days prior to commencing well
This card void if drilling not started within six (6) months of date received by K.C.C.


MAY 22 1985

5-22-85

CONSERVATION DIVISION
A Regular Section of Land
1 Mile = 5,280 Ft.

Important procedures to follow :

1. Notify District office before setting surface casing.
2. Set surface casing by circulating cement to the top.
3. File completion forms ACO-1 with K.C.C. within 90 days of well completion, following instructions on ACO-1, side 1, and including copies of wireline logs.
4. Notify District office 48 hours prior to old well workover or re-entry.
5. Prior to plugging, prepare a plugging plan, then obtain agreement from the appropriate district office for an approved plugging plan.
6. Submit plugging report (CP-4) to K.C.C. after plugging is completed.
7. Obtain an approved injection docket number before disposing of salt water.
8. Notify K.C.C. within 10 days when injection commences or terminates.
9. If an alternate 2 completion, cement in the production pipe from below any usable water to surface within 120 days of spud date.

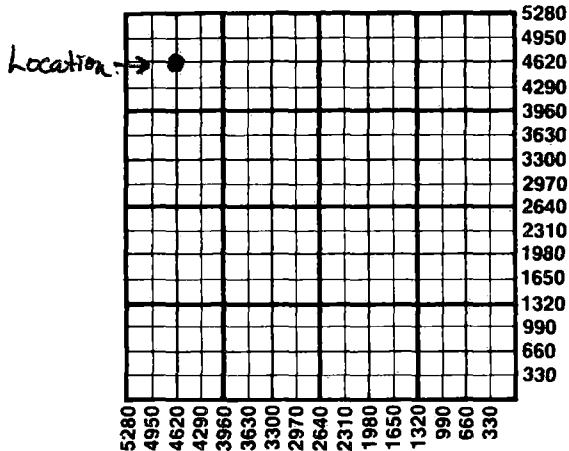

State Corporation Commission of Kansas
Conservation Division
200 Colorado Derby Building
Wichita, Kansas 67202
(316) 263-3238