

STATE OF KANSAS
STATE CORPORATION COMMISSION


WELL PLUGGING RECORD

Give All Information Completely
Make Required Affidavit
Mail or Deliver Report to:
Conservation Division
State Corporation Commission
800 Bitting Building
Wichita, Kansas

FORMATION PLUGGING RECORD

Strike out upper line
when reporting plug-
ging off formations.

Barton County NE/4 Sec 27 Twp 20 Rge 12 (E) W (W)
Location as "NE $\frac{1}{4}$ NW $\frac{1}{4}$ SW $\frac{1}{4}$ " or footage from lines 330' fr EL and 990' fr NL
Lease Owner Phillips Petroleum Company
Lease Name Emma Well No 2
Office Address Box 779 Great Bend, Kansas
Character of Well (completed as Oil, Gas or Dry Hole) Completed as Dry Hole
Date well completed May 4, 19 49
Application for plugging filed May 9, 19 49
Application for plugging approved May 11, 19 49
Plugging commenced May 12, 19 49
Plugging completed May 14, 19 49
Reason for abandonment of well or producing formation Dry Hole

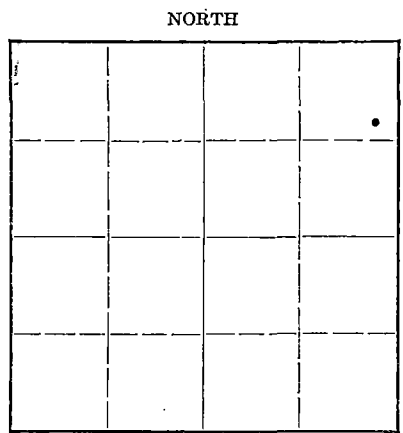

Locate well correctly on above
Section Plat

If a producing well is abandoned, date of last production 19
Was permission obtained from the Conservation Division or its agents before plugging was com-
menced? Yes

Name of Conservation Agent who supervised plugging of this well C. D. Stough
Producing formation Arbuckle Depth to top 3388' Bottom Total Depth of Well 3470 Feet
Show depth and thickness of all water, oil and gas formations.

OIL, GAS OR WATER RECORDS

CASING RECORD

Formation	Content	From	To	Size	Put In	Pulled Out
Heebner	Dry	3014		8 5/8"	265'	None
Toronto	Dry	3032				
Brown Lime	Dry	3137				
L.K.C.	Dry	3153	3381			
Arbuckle	Show of oil	3388		5 1/2"	3380'	2696'

Describe in detail the manner in which the well was plugged, indicating where the mud fluid was placed and the method or methods used in introducing it into the hold. If cement or other plugs were used, state the character of same and depth placed, from feet to feet for each plug set.

Rocked hole from 3470' to 3370'. Ran 3 sax cement and 1 sack
Calseal from 3370' to 3352'. Shot pipe at 2800', 2750' and
2700'. Pipe loose. Pulled 70 joints pipe. Mudded hole to
270'. Ran 15 sax cement. Mudded hole to 30'. Ran 10 sax
cement to cap. Plugging completed.

RECEIVED

MAY 19 1949

STATE CORPORATION
COMMISSION
KANSAS

5-19-1949

(If additional description is necessary, use BACK of this sheet)

Correspondence regarding this well should be addressed to Phillips Petroleum Company
Address Box 779 Great Bend, Kansas

STATE OF Kansas, COUNTY OF Barton, ss.
A. L. Rhodes (employee of owner) or ~~agent~~ of the above-described well,
being first duly sworn on oath, says: That I have knowledge of the facts, statements, and matters herein contained and the log of the above-
described well as filed and that the same are true and correct. So help me God.

(Signature) A. L. Rhodes
Box 779 Great Bend, Kansas
(Address)

SUBSCRIBED AND SWORN TO before me this 17th day of May, 19 49
J. Marsh
Notary Public.

My commission expires March 27, 1950

PLUGGING
FILE SEC 27 T 20 R 12 W
BOX 779 GREAT BEND KANSAS

Form No. 879

Formation Record

Lease Raza

Well No. 2

FROM	TO	Formation	REMARKS
0	10	Sand	Elevation 1826' BS
10	170	Surface Clay & Sand	
170	285	Shale & Clay	
285	605	Anhydrite	
605	1425	Shale & Shells	
1425	1600	Shale	
1600	2140	Lime & Shale	
2140	2330	Shale & Shells	
2330	3392	Lime & Shale	
3392	3470	Lime	

Top Heebner 3014'
 Top Toronto 3032'
 Top Brown Line 3137'
 Top L.K.C. 3153'
 Base L.K.C. 3381'
 Top Arbuckle 3388'

3158-61' Poor crystalline porosity, very slight spotted stain.
 3172-80' Fair oolitic and oolitic porosity, light spotted stain, trace light even stain, no odor.
 3197-3202' Fair vugular and slightly oolitic porosity, light spotted to even stain, very faint odor.
 3214-18' Poor crystalline porosity, trace of spotted stain.
 3240-46' Fair oolitic and slightly oolitic porosity, no shows.
 3261-90' Poor oolitic porosity, no shows.
 3317-24' Poor oolitic porosity, no shows.

Arbuckle Dolomite

3388-92' HSD Fair porosity, light spotted to even stain, fair odor.

RECEIVED

MAY 11 1949

PLUGGING
 FILE SEC 27-20 R 120
 BOOK PAGE 46 LINE 5