


WELL PLUGGING RECORD

Give All Information Completely  
Make Required Affidavit  
Mail or Deliver Report to:  
Conservation Division  
State Corporation Commission  
211 No. Broadway  
Wichita, Kansas

Barton County. Sec. 27 Twp. 20S Rge. 12W(E) (W)

Location as "NE/CNW/SW" or footage from lines SE NE NW  
Lease Owner West Supply Co., Inc.  
Lease Name Churchill "A" Well No. 1  
Office Address Box 506 - Chase, Kansas  
Character of Well (completed as Oil, Gas or Dry Hole) Oil well  
Date well completed October 16 1948  
Application for plugging filed May 21 1957  
Application for plugging approved May 23 1957  
Plugging commenced May 22 1957  
Plugging completed May 25 1957  
Reason for abandonment of well or producing formation Depleted.

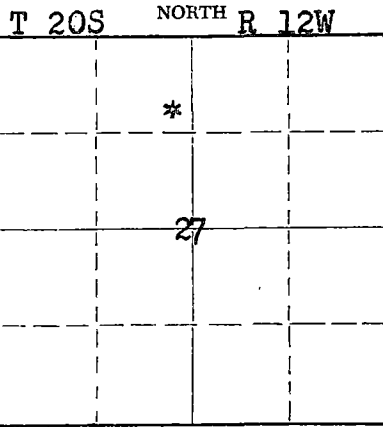

Locate well correctly on above Section Plat

If a producing well is abandoned, date of last production April 1957  
Was permission obtained from the Conservation Division or its agents before plugging was commenced? Yes

Name of Conservation Agent who supervised plugging of this well Brundage  
Producing formation \_\_\_\_\_ Depth to top \_\_\_\_\_ Bottom \_\_\_\_\_ Total Depth of Well 3407 Feet  
Show depth and thickness of all water, oil and gas formations.

OIL, GAS OR WATER RECORDS

CASING RECORD

FORMATION	CONTENT	FROM	TO	SIZE	PUT IN	PULLED OUT
				8-5/8"	261'	None
				5-1/2"	3392'	2700'

Describe in detail the manner in which the well was plugged, indicating where the mud fluid was placed and the method or methods used in introducing it into the hole. If cement or other plugs were used, state the character of same and depth placed, from \_\_\_\_\_ feet to \_\_\_\_\_ feet for each plug set.

Filled the hole with sand from 3407' to 3355' and ran 5 sacks of cement. Mudded the hole to 240', set a 10' rock bridge and ran 20 sacks of cement. Mudded the hole to 25', set a 10' rock bridge and ran 5 sacks of cement on top. Plugging completed.

(If additional description is necessary, use BACK of this sheet)

Name of Plugging Contractor West Supply Co., Inc.  
Address Chase, Kansas

STATE OF Kansas, COUNTY OF Rice, ss.  
Noel J. Knight (employee of owner) or (owner or operator) of the above-described well, being first duly sworn on oath, says: That I have knowledge of the facts, statements, and matters herein contained and the log of the above-described well as filed and that the same are true and correct. So help me God.

(Signature) Noel J. Knight  
Chase, Kansas (Address)

SUBSCRIBED AND SWORN TO before me this 27th. day of May 1957

My commission expires 2/4/59

[Signature]  
Notary Public.  
STATE CORPORATION COMMISSION

PLUGGING  
FILE NO. 27T 20 R 12W  
BOOK PAGE 14 LINE 34

JUN 4 1957  
CONSERVATION DIVISION  
Wichita, Kansas

6-4-1957


WELL LOG BUREAU KANSAS GEOLOGICAL SOCIETY  
412 Union National Bk. Bldg., Wichita, Kansas

Company - ALPINE OIL AND ROYALTY CO., INC.  
Farm - Churchill No. 1

SEC. 27 T. 20 R. 12W  
SE NE NW

Total Depth. 3402 *Drilled to 3407 w/ cable Tools*  
Comm. 9-30-48 Comp. 10-16-48  
Shot or Treated.  
Contractor. Quaker Drlg. Co.  
Issued. 1-8-49

County. Barton  
KANSAS

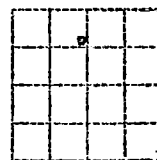

Elevation. \_\_\_\_\_

Production. Swbd 5 BOPH, 12 hrs.

Figures Indicate Bottom of Formations.

sand	210
shale, shells	261
shale, shells, redbed	605
anhydrite	630
shale, red bed	642
shale, shells, redbed	722
shale, shells	1450
shale, lime	2230
shale, shells	2510
lime, shale	2670
soft lime	2685
lime, shale	2955
lime	2957
sand	2959
lime, shale	3168
lime	3241
lime, shale	3374
lime RTD	3388
lime	3402
total depth	

Tops:

Heebner shale	3007
Brown lime	3132
White Lansing	3150
Conglomerate	3377
Arbuckle	3384

PLUGGING  
FILE SEC. 27 T. 20 R. 12W  
BOOK PAGE 14 LINE 34