


WELL PLUGGING RECORD

Give All Information Completely
Make Required Affidavit
Mail or Deliver Report to:
Conservation Division
State Corporation Commission
800 Bitting Building
Wichita, Kansas

NORTH

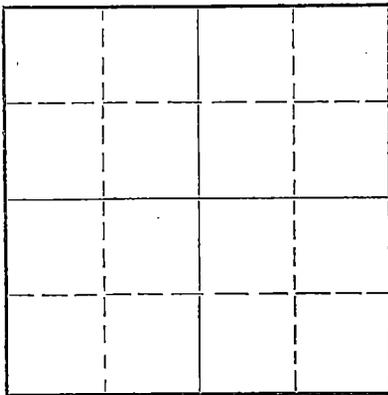

Locate well correctly on above
Section Plat

Barton County. Sec. 27 Twp. 20 Rge. (E) 12 (W)
Location as "NE/CNW/SW" or footage from lines. NW NW SW/4
Lease Owner M. B. Armer
Lease Name Bryant Well No. 2
Office Address 710 Petroleum Bldg., Wichita, Kansas
Character of Well (completed as Oil, Gas or Dry Hole) dry
Date well completed Aug. 28 19 53
Application for plugging filed Aug. 28 19 53
Application for plugging approved Aug. 28 19 53
Plugging commenced Aug. 28 19 53
Plugging completed Aug. 28 19 53
Reason for abandonment of well or producing formation dry

If a producing well is abandoned, date of last production 19
Was permission obtained from the Conservation Division or its agents before plugging was commenced? Yes

Name of Conservation Agent who supervised plugging of this well C. D. Stough
Producing formation Depth to top Bottom Total Depth of Well 3458 Feet
Show depth and thickness of all water, oil and gas formations.

OIL, GAS OR WATER RECORDS

CASING RECORD

FORMATION	CONTENT	FROM	TO	SIZE	PUT IN	PULLED OUT
				8 5/8	258'	None

Describe in detail the manner in which the well was plugged, indicating where the mud fluid was placed and the method or methods used in introducing it into the hole. If cement or other plugs were used, state the character of same and depth placed, from feet to feet for each plug set.

Filled hole with heavy Rotary mud to 240 ft.
set plug and 15 sacks cement through drill pipe.
Mudded hole to 30 ft. set plug and 10 sacks
cement at the surface.

REC
STATE CORP COM
CON
9-2-1953

(If additional description is necessary, use BACK of this sheet)
Name of Plugging Contractor M. B. Armer
Address Wichita, Kansas

STATE OF KANSAS, COUNTY OF SEDGWICK, ss.
L. C. Sponenberg (employee of owner) or (owner or operator) of the above-described well, being first duly sworn on oath, says: That I have knowledge of the facts, statements, and matters herein contained and the log of the above-described well as filed and that the same are true and correct. So help me God.

(Signature) *L. C. Sponenberg*
(Address)

SUBSCRIBED AND SWORN TO before me this 31st day of August, 19 53

My commission expires February 13, 1956. *Core Fussey* Notary Public.

PLUGGING
FILE SEC 27 20 R 12 W
BOOK PAGE 126 LINE 11