


WELL PLUGGING RECORD

Divulged Information Completely
Make Required Affidavit
Mail or Deliver Report to:
Conservation Division
State Corporation Commission
211 No. Broadway
Wichita, Kansas

Barton County. Sec. 26 Twp. 20s Rge. - (E) 14 (W)

Location as "NE/CNW/SW" or footage from lines NE NE SW
Lease Owner WILKINSON DRILLING, INC.
Lease Name WEATHERS Well No. 1
Office Address 1121 Union National Building, Wichita 2, Kansas
Character of Well (completed as Oil, Gas or Dry Hole) Dry
Date well completed September 19, 1958
Application for plugging filed September 19, 1958
Application for plugging approved September 19, 1958
Plugging commenced September 19, 1958
Plugging completed September 19, 1958
Reason for abandonment of well or producing formation No commercial quantity of oil and/or gas was encountered.

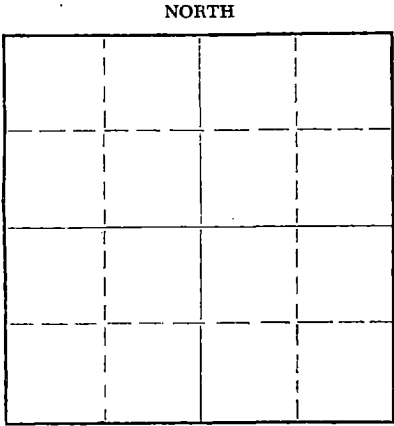

Locate well correctly on above Section Plat

If a producing well is abandoned, date of last production - 19-
Was permission obtained from the Conservation Division or its agents before plugging was commenced? Yes

Name of Conservation Agent who supervised plugging of this well Frank Broadfoot
Producing formation - Depth to top - Bottom - Total Depth of Well - Feet
Show depth and thickness of all water, oil and gas formations.

OIL, GAS OR WATER RECORDS

CASING RECORD

FORMATION	CONTENT	FROM	TO	SIZE	PUT IN	PULLED OUT

Describe in detail the manner in which the well was plugged, indicating where the mud fluid was placed and the method or methods used in introducing it into the hole. If cement or other plugs were used, state the character of same and depth placed, from - feet to - feet for each plug set.
Filled hole with heavy mud. Set bottom plug @ 350' w/ 1 sack hulls and 250 sacks cement. Set top plug @ 40' w/ 1 sack hulls and 10 sacks cement.

(If additional description is necessary, use BACK of this sheet)
Name of Plugging Contractor WILKINSON DRILLING, INC.
Address 1121 Union National Building, Wichita 2, Kansas

STATE OF Kansas, COUNTY OF Sedgwick, ss.
Walter M. Wilkinson (employee of owner) or (owner or operator) of the above-described well, being first duly sworn on oath, says: That I have knowledge of the facts, statements, and matters herein contained and the log of the above-described well as filed and that the same are true and correct. So help me God.

(Signature) Walter M. Wilkinson
1121 Union Nat'l. Bldg., Wichita 2, Kansas
(Address)

SUBSCRIBED AND SWORN to before me this 17th day of November, 19 58

My commission expires January 2, 1961
Carolyn K. Moore
STATE CORP. COM. Notary Public.

PLUGGING
FILE SEC. 26 T. 20 R. 14W
BOOK PAGE 135 LINE 7

NOV 19 1958
CONSERVATION DIVISION
11-19-1958

WILKINSON DRILLING, INC.

1121 Union National Building

Wichita 2, Kansas

October 30, 1958

WEATHERS #1

Company	- WILKINSON DRILLING, INC.	Location	- NE NE SW, Sec. 26-20s-14w, Barton County, Kansas
Contractor	- Company Tools	Elevation	- 1903' KB
Commenced	- September 13, 1958	Casing	- 8 5/8" @ 496' w/350 sks Sunset
Completed	- September 19, 1958		
Total Depth	- 3548'		

FIGURES INDICATE BOTTOMS OF FORMATIONS

<u>Depth</u>	<u>Formation</u>
0 - 295	Sand and clay.
295 - 450	Shale and shells.
450 - 496	Red beds and shale.
496 - 817	Shale and red beds.
817 - 830	ANHYDRITE.
830 - 1610	Shale and shells.
1610 - 1755	Shale and lime.
1755 - 2085	Lime and shale.
2085 - 2920	Shale and lime.
2920 - 3065	Lime and shale.
3065 - 3250	Limed shale.
3250 - 3310	Lime and shale.
3310 - 3465	Lime.
3465 - 3525	Lime and shale.
3525 - 3548	Lime.

We hereby certify the above and foregoing to be a true and correct copy of the Log on the Weathers #1, located in the NE NE SW, Sec. 26-20s-14w, Barton County, Kansas.

WILKINSON DRILLING, INC.

Walter M. Wilkinson

Subscribed and sworn to before me this thirtieth day of October, nineteen hundred and fifty-eight.

Carolyn K. Moore

My commission expires January 2, 1961.

PLUGGING	
FILE	SEC. 26 T. 20 R. 14W
BOOK	PAGE 135 LINE 7

RECEIVED
STATE CORPORATION COMMISSION

NOV 19 1958

COMMISSION