

STATE OF KANSAS
STATE CORPORATION COMMISSION

WELL PLUGGING RECORD


OR

FORMATION PLUGGING RECORD

Strike out upper line
when reporting plugging
of formations.

Give All Information Completely
Make Required Affidavit
Mail or Deliver Report to:
Conservation Division
State Corporation Commission
800 Bitting Building
Wichita, Kansas

Barton County. Sec. 26 Twp. 20S Rge. (E) 14 (W)
Location as "NE $\frac{1}{4}$ NW $\frac{1}{4}$ SW $\frac{1}{4}$ " or footage from lines SW SE NW
Lease Owner The Bay Petroleum Corporation
Lease Name Janne Well No. 1
Office Address Box 957, Denver Colorado.
Character of Well (completed as Oil, Gas or Dry Hole) Oil well
Date well completed May, 15, 1946
Application for plugging filed Feb, 15, 1949
Application for plugging approved Feb. 17 1949
Plugging commenced March, 18 1949
Plugging completed March, 25 1949
Reason for abandonment of well or producing formation Failure to produce in
commercial quantity.
If a producing well is abandoned, date of last production Jan, 10, 1949
Was permission obtained from the Conservation Division or its agents before plugging was com-
menced? Yes

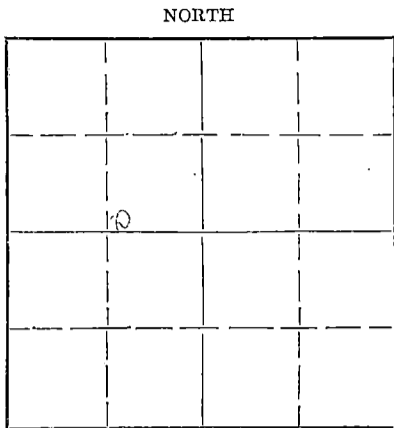

Locate well correctly on above
Section Plat

Name of Conservation Agent who supervised plugging of this well Mr. C.D. Stough
Producing formation Arbuckle Depth to top 3539 Bottom 3547 Total Depth of Well 3547 Feet
Show depth and thickness of all water, oil and gas formations.

OIL, GAS OR WATER RECORDS

CASING RECORD

Formation	Content	From	To	Size	Put In	Pulled Out
				8 5/8"	823'	None
				5 1/2"	3540'	2551'

Describe in detail the manner in which the well was plugged, indicating where the mud fluid was placed and the method or methods used in introducing it into the hole. If cement or other plugs were used, state the character of same and depth placed, from.....feet to.....feet for each plug set.

March, 18, 1949 - Ran 5 sacks cement to bottom of hole;
March, 25, 1949 - Mudded hole, set bridge at 250', and
ran 15 sacks of cement;
Mudded hole and ran 10 sacks of cement
to base of cellar.

(If additional description is necessary, use BACK of this sheet)

Correspondence regarding this well should be addressed to The Bay Petroleum Corporation,
Address Box 513, Chase, Kansas.


STATE OF Kansas, COUNTY OF Rice, ss.
Forrest Crawford (employee of owner) or (owner or operator) of the above-described well,
being first duly sworn on oath, says: That I have knowledge of the facts, statements, and matters herein contained and the log of the above-
described well as filed and that the same are true and correct. So help me God.

(Signature) Forrest Crawford
4-12-1949 (Address)

SUBSCRIBED AND SWORN to before me this 9 th day of April, 1949

My commission expires May, 20, 1950

Lincoln O. Gray
Notary Public.

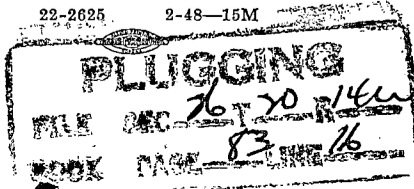

WELL LOG BUREAU KANSAS GEOLOGICAL SOCIETY
412 Union National Bank Bldg, Wichita, Kans.

COMPANY C U Baay
FARM Janne

No. 1

Sec. 26 T. 20 R 14W,
SW SE NW

Total Depth . 3547'

County . Barton
KANSAS

Comm. 3-31-46 Comp. 5-15-46

Shot or treated

Contractor Peel Drlg. Co.

Issued 6-1-46

3" CASING 3540' DF

Elevation

Figures Indicate Bottom of Formation.

sand 0 - 40
sand 180
shale & shell 405
sand and shale 468
sand and shale strks 620
shale and snails 815
anhydrite 841
shale and shells 1350
salt and snale 1538
shale and lime 1600
lime & shale strks 1690
anhydrite 1820
cherty lime 1835
lime 1840
lime brkn 1990
cherty lime 2004
lime 2008
lime and shale 2111
lime 2188
lime and shale 2276
lime brkn 2322
shale and lime 2523
lime brkn & shale 2620
lime 2630
lime and shale 2694
lime brkn & shale 2776
shale and lime 2938
lime cherty 2952
lime & shale strks 2999
lime 3198
lime and shale 3283
lime 3515
lime brkn 3521
lime 3542
Arbuckle lime 3547
Total Depth

TOPS
Anhydrite 815
Brwn lns. 3265
Lns. 3280
Congl. 3514
Simpson 3531
Arbuckle 3539

TESTING
DD 3546 test 70 gal per hr
DD 3549 500 acid
Swab 12 BOPH

T.D. w/rotary

RECEIVED
APR 12 1949
SE. ...
KANSAS

PLUGGING
FILE SEC 26 T. 20 R. 14W
BOOK PAGE 83 LINE 16