

2


STATE OF KANSAS
STATE CORPORATION COMMISSION

Form CP-4

Give All Information Completely
Make Required Affidavit
Mail or Deliver Report to:
Conservation Division
State Corporation Commission
212 No. Market
Wichita, Kansas

WELL PLUGGING RECORD

BARTON County. Sec. 26 Twp. 20 Rge. 14 (E) (W)
Location as "NE/CNW/SW" or footage from lines CWL SE NW
Lease Owner Hummon Oil, Inc.
Lease Name Janne Well No. 1
Office Address Wichita, Kansas
Character of Well (completed as Oil, Gas or Dry Hole) Dry Hole
Date well completed 21 August 19 67
Application for plugging filed 21 August 19 67
Application for plugging approved 21 August 19 67
Plugging commenced 21 August 19 67
Plugging completed 21 August 19 67
Reason for abandonment of well or producing formation Dry Hole

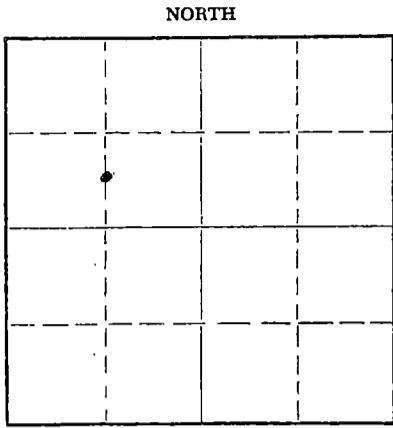

Locate well correctly on above
Section Plat

If a producing well is abandoned, date of last production 19
Was permission obtained from the Conservation Division or its agents before plugging was commenced? Yes

Name of Conservation Agent who supervised plugging of this well Don Truan
Producing formation _____ Depth to top _____ Bottom _____ Total Depth of Well 3570 Feet
Show depth and thickness of all water, oil and gas formations.

OIL, GAS OR WATER RECORDS				CASING RECORD		
FORMATION	CONTENT	FROM	TO	SIZE	PUT IN	PULLED OUT

Describe in detail the manner in which the well was plugged, indicating where the mud fluid was placed and the method or methods used in introducing it into the hole. If cement or other plugs were used, state the character of same and depth placed, from _____ feet to _____ feet for each plug set.

Filled hole with heavy mud to 250'. Set plug and hulls, and 60 sacks of cement with Halliburton Pump Truck.

Filled hole to 40' and set plug and hulls and ten sacks of cement.

Put two sacks of cement in rat hole.

RECEIVED
CONSERVATION DIVISION
AUG 31 1967
CONSERVATION DIVISION
WICHITA, KANSAS
8-31-1967

(If additional description is necessary, use BACK of this sheet)


Name of Plugging Contractor Burt Drilling Co.
Address 1821 Washington, Great Bend, Kansas 67530

STATE OF KANSAS, COUNTY OF BARTON, ss.
Duke C. Burt (employee of owner) or (owner or operator) of the above-described

well, being first duly sworn on oath, says: That I have knowledge of the facts, statements, and matters herein contained and the log of the above-described well as filed and that the same are true and correct. So help me God.

(Signature) Duke C. Burt
1823 Washington, Great Bend, Kansas
(Address)

SUBSCRIBED AND SWORN to before me this 30th day of August, 1967

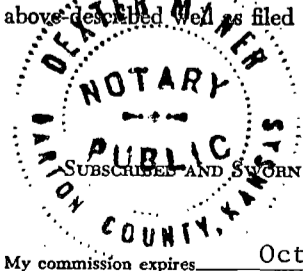

Dexter Miner
Notary Public.

My commission expires Oct. 15, 1967

26-20-14W

15.009.20095.0000

9

HUMMON OIL, INC.
821 Union National Bldg.
Wichita, Kansas

Well: Janne A-1
Commenced R.D.: 8-11-67
Completed R.D.: 8-21-67
Total Depth: 3570' D. F.
Casing: Ran 240' of 8 5/8" 24# 8rd thrd
Surface Pipe.

Sec.: 26-20S-14W
Barton County, Kansas
Elevation:
Initial Prod.: D. & A.
Contractor: BURT DRILLING
COMPANY

Strata	Depth
Sand	0- 160'
Shale	160- 240
Shale and Shells	240- 595
Shale and Red Bed	595- 815
Anhydrite	815- 839
Shale and Shells	839-1615
Shale and Lime Streaks	1615-1645
Lime w/Shale Streaks	1645-1825
Lime	1825-2016
Lime & Shale	2016-2230
Shale & Lime	2230-2400
Lime & Shale	2400-2825
Lime w/Shale Streaks	2825-2930
Shale & Lime	2930-3025
Lime	3025-3205
Shale	3205-3272
Lime (Brown)	3272-3282
Lansing Lime	3282-3303
Lime	3303-3448
Lime (BKC 3517')	3448-3517
Lime & Shale	3517-3529
Conglomerate	3529-3535
Lime	3535-3560
Arbuckle	3560-3570

RECEIVED
STATE CORPORATION COMMISSION

SEP 1 1967

CONSERVATION DIVISION
Wichita, Kansas

I hereby certify that the above is a true and correct log of said well as reflected by daily reports.

BURT DRILLING CO.

[Signature]

Signed and sworn in my presence this 23rd day of August, 1967.

[Signature]
Edwin H. Mauler

My Commission Expires: July 2, 1969

