

WELL PLUGGING RECORD

Give All Information Completely  
Make Required Affidavit  
Mail or Deliver Report to:  
Conservation Division  
State Corporation Commission  
800 Bittling Building  
Wichita, Kansas

Barton

County. Sec. 26 Twp. 20S Rge. 14 (W)

Location as "NE/CNW $\frac{1}{4}$ SW $\frac{1}{4}$ " or footage from lines 990' NSL & 2310' EWL of SW/4

Lease Owner Gulf Oil Corporation

Lease Name T. Taylor Well No. 1

Office Address Box 661, Tulsa, Oklahoma

Character of Well (completed as Oil, Gas or Dry Hole) Dry hole

Date well completed October 18, 1944

Application for plugging filed April 21, 1950

Application for plugging approved April 22, 1950


Plugging commenced April 28, 1950

Plugging completed May 5, 1950

Reason for abandonment of well or producing formation Well has been held TA for SWD but is not now needed.

If a producing well is abandoned, date of last production None 19

Was permission obtained from the Conservation Division or its agents before plugging was commenced? Yes

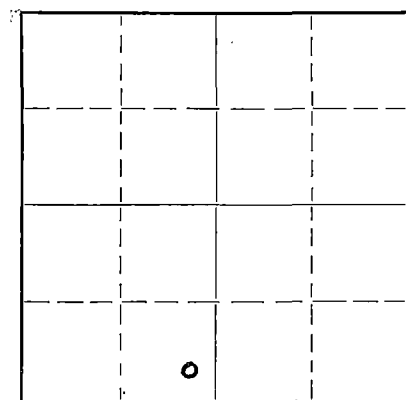

Locate well correctly on above Section Plat

Name of Conservation Agent who supervised plugging of this well Mr. C. D. Stough

Producing formation Arbuckle Depth to top 3528 Bottom 3576 $\frac{1}{2}$  Total Depth of Well 3576 $\frac{1}{2}$  Feet

Show depth and thickness of all water, oil and gas formations.

OIL, GAS OR WATER RECORDS

CASING RECORD

Formation	Content	From	To	Size	Put In	Pulled Out
				13-5/8"	228'	None
				8-5/8"	852'	None
				5-1/2"	3530'	2872'
				4-1/2"	58	None

Describe in detail the manner in which the well was plugged, indicating where the mud fluid was placed and the method or methods used in introducing it into the hole. If cement or other plugs were used, state the character of same and depth placed, from \_\_\_\_\_ feet to \_\_\_\_\_ feet for each plug set.

Plugged bottom of hole from 3576 $\frac{1}{2}$ ' to 3518' with sand and 5 sacks cement. Ripped 5 $\frac{1}{2}$ " casing at 3100' and 3010' and pulled 17" tension but unable to start. Ripped 5 $\frac{1}{2}$ " casing at 2830'. Pulled 19" tension. Spotted 65 Bbls. oil. Recovered 90 jts. 5 $\frac{1}{2}$ ". 2872'. Mudded hole to 250', placed bridge and dumped 20 sacks cement. Mudded hole to 30' and capped with 10 sacks cement.

(If additional description is necessary, use BACK of this sheet)

Correspondence regarding this well should be addressed to Mr. S. G. Sanderson  
Address Box 661, Tulsa, Oklahoma

STATE OF Kansas, COUNTY OF Rice, ss.

H. H. Wright

(employee of owner) of the above-described well,

being first duly sworn on oath, says: That I have knowledge of the facts, statements, and matters herein contained and the log of the above-described well as filed and that the same are true and correct. So help me God.

(Signature)

*H. H. Wright*  
(Address)

SUBSCRIBED AND SWORN TO before me this 14th day of June, 1950

My commission expires

April 14, 1952

4-49-10M

Notary Public.

