


Give All Information Completely
Make Required Affidavit
Mail or Deliver Report to:
Conservation Division
State Corporation Commission
211 No. Broadway
Wichita, Kansas

WELL PLUGGING RECORD

PAWNEE County, Sec. 6 Twp. 23 Rge. 17W(E) (W)
Location as "NE/CNW/SW" or footage from lines E/2 E/2 SE
Lease Owner SANTA FE PIPE & SUPPLY, INC.
Lease Name SHOWALTER Well No. 2
Office Address P. O. BOX 562 - GREAT BEND, KANSAS
Character of Well (completed as Oil, Gas or Dry Hole) OIL
Date well completed AUGUST 8 19 55
Application for plugging filed MAY 23 19 64
Application for plugging approved MAY 25 19 64
Plugging commenced JUNE 11 19 64
Plugging completed XXXXX JULY 9 19 64
Reason for abandonment of well or producing formation DEPLETED

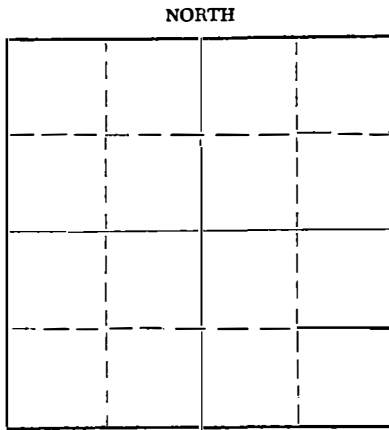

Locate well correctly on above
Section Plat

If a producing well is abandoned, date of last production _____ 19____
Was permission obtained from the Conservation Division or its agents before plugging was commenced? YES

Name of Conservation Agent who supervised plugging of this well MR. ELDON PERRY
Producing formation _____ Depth to top _____ Bottom _____ Total Depth of Well 4290 Feet
Show depth and thickness of all water, oil and gas formations.

OIL, GAS OR WATER RECORDS				CASING RECORD		
FORMATION	CONTENT	FROM	TO	SIZE	PUT IN	PULLED OUT
				8 5/8"	216'	NONE
				5 1/2"	4290'	2322'

Describe in detail the manner in which the well was plugged, indicating where the mud fluid was placed and the method or methods used in introducing it into the hole. If cement or other plugs were used, state the character of same and depth placed, from _____ feet to _____ feet for each plug set.

PLUGGED BACK WITH SAND FROM 4262' TO 4210'. MIXED AND DUMPED 4 SACKS OF CEMENT FROM 4210' TO 4178'. PULLED CASING. MIXED & PUMPED IN 40 SACKS OF GEL MUD. PUT IN PLUG. MIXED AND PUMPED IN 100 SACKS OF CEMENT WITH 2% CALCIUM CHLORIDE FROM 300' TO BASE OF THE CELLAR.

RECEIVED
STATE CORPORATION COMMISSION

8-20-64
AUG 20 1964

(If additional description is necessary, use BACK of this sheet)
Name of Plugging Contractor ACE PIPE PULLING COMPANY Wichita, Kansas
Address P. O. BOX 304 - GREAT BEND, KANSAS

STATE OF KANSAS, COUNTY OF BARON, ss.

T. L. NUTT (Employee of owner) or (owner or operator) of the above-described well, being first duly sworn on oath, says: That I have knowledge of the facts, statements, and matters herein contained and the log of the above-described well as filed and that the same are true and correct. So help me God.

(Signature) T. L. Nutt

P. O. BOX 562 - GREAT BEND, KANSAS
(Address)

Subscribed and sworn to before me this 13TH day of AUGUST, 19 64

My commission expires JULY 31, 1966
Mary M. Guesnier Notary Public.

WELL LOG BUREAU - KANSAS GEOLOGICAL SOCIETY
508 East Murdock, Wichita, Kansas

15-145-01182-0000
COPY


Company. WELCH & OLSSON DRILLING CO., INC.
Farm. Showalter No. 2

SEC. 6 T. 23 R. 17W
C E/2 E/2 SE

Total Depth. 4290
Comm. 7-28-55 Comp. 8-8-55
Shot or Treated.

County Pawnee
KANSAS

Contractor. Welch & Olsson Drilling Co., Inc.
Issued. 10-29-55

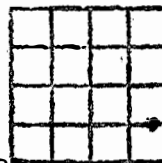

8 5/8 CASING:
216' w/ 175 sx. cmt.

Elevation. 2070 RB

Production. 141 BOPD

Figures indicate Bottom of Formations.

sand	20
clay	150
shale & shells	215
shale	360
red bed	570
sand	720
shale	910
red bed	1200
shale & shells	1955
lime	2160
shale & lime	2285
lime w/ chert streaks & sand	2305
lime & shale	2390
lime w/ sand & pyrite	2435
lime & shale	2800
shale & shells	3150
shale & lime	3385
lime	3475
lime & shale	3550
lime	3650
lime & shale	3752
lime & chert	3765
lime	4194
chert	4229
sand	4243
shale & chert	4250
chert	4290
Total Depth	

TOPS:	
Heebner	3627
Brown lime	3731
Lansing-KC	3739
Conglomertae-shaley	4162
Conglomerate-cherty	4194
(Mississippi)	
Conglomerate-sand (Misener)	4229
Viola	4266

RECEIVED
STATE CORPORATION COMMISSION

AUG 20 1964

CONSERVATION DIVISION
Wichita, Kansas