

DISTRICT CONSERVATION AGENT'S REPORT

TO:

State Corporation Commission
Conservation Division
800 Bitting Building
Wichita, Kansas

FILE NO. 78-3

LOCATION SE

SEC. 31 TWP. 19 RGE. 10W

Dry Hole _____ Abandoned Oil Well Abandoned Gas Well _____

I have today completed supervision of plugging of:

Well No. 12 Lease Krampe

Operator Phillips Petr. Co Address St Bend Kans

Field Silica County Rice


Total Depth 3390 Feet.

(Describe briefly the manner in which the well was plugged)

Previously P.B. to 3161 -
6 sac^{cement} dumped at 3060 and hole made
solid at 190 and 25 sac of cement
dumped at 190 " 8 " " " at
top of surface pipe.
The above intervals mudded with
heavy mud.

Robert Durbin
District Conservation Agent

FILE 31 19 10W
BOOK 78 3

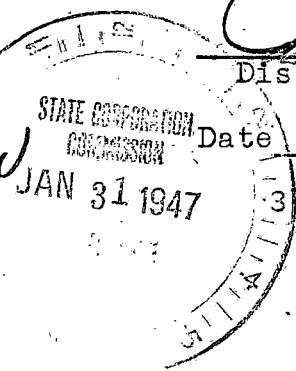

Date 1-29-47