


STATE OF KANSAS  
STATE CORPORATION COMMISSION  
Give All Information Completely  
Make Required Affidavit  
Mail or Letter Report to:  
Conservation Division  
State Corporation Commission  
800 Bitting Building  
Wichita, Kansas

WELL PLUGGING RECORD  
OR  
FORMATION PLUGGING RECORD

Strike out upper line  
when reporting plugging  
of formations.

Rice County. Sec. 24 Twp 19S Rge. (E) 10 (W)  
Location as "NE 1/4 NW 1/4 SW 1/4" or footage from lines 330' W. of E. line and 660'  
Lease Owner: S of N line of NW 1/4 The Bradley Oil Co et al  
Lease Name: H. Ruhl Well No. 1  
Office Address: 402 Brown Bldg., Wichita, Kansas  
Character of Well (Completed as Oil, Gas or Dry Hole): dry hole  
Date, well completed: June 30th, 1939 193  
Application for plugging filed: June 30th, 1939 193  
Application for plugging approved: June 30th, 1939 193  
Plugging Commenced: 4 p.m. June 30th, 1939 193  
Plugging Completed: July 1st, 1939 193  
Reason for abandonment of well or producing formation: dry hole

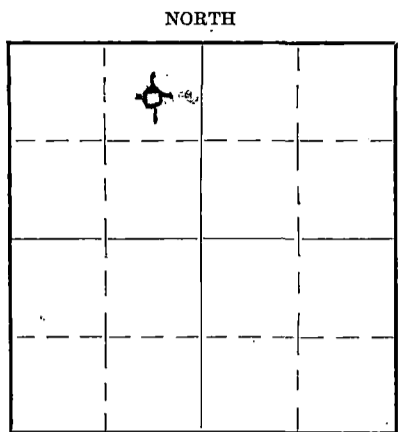

Locate well correctly on above  
Section Plat

If a producing well is abandoned, date of last production 193  
Was permission obtained from the Conservation Division or its agents before plugging was com-  
menced? yes

Name of Conservation Agent who supervised plugging of this well: Mr. Alexander  
Producing formation: none Depth to top: Bottom: Total Depth of Well: 3352 Feet.  
Show depth and thickness of all water, oil and gas formations.

OIL, GAS OR WATER RECORDS


CASING RECORD

Formation	Content	From	To	Size	Put In	Pulled Out
Arbuckle	nil	3316	3352	10"	207	none

Describe in detail the manner in which the well was plugged, indicating where the mud fluid was placed and the method or methods used in introducing it into the hole. If cement or other plugs were used, state the character of same and depth placed, from feet to feet for each plug set.

Mudded to bottom of surface casing, put in 15 sax cement, mudded, and then surface casing capped with 15 sax cement under direction your Mr. Alexander

PLUGGING  
FILE SEC 24 T 19 R 100  
BOOK PAGE 67 LINE 24

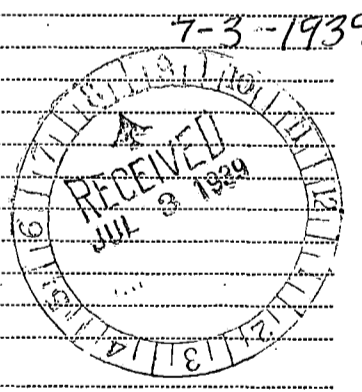

(If additional description is necessary, use BACK of this sheet)

Correspondence regarding this well should be addressed to: The Bradley Oil Co.  
Address: 402 Brown Bldg., Wichita, Kansas.

STATE OF Kansas, COUNTY OF Sedgwick, ss.  
Claude J. Dillon (employee of owner) or (owner or operator) of the above-described well,

being first duly sworn on oath, says: That I have knowledge of the facts, statements, and matters herein contained and the log of the above-described well as filed and that the same are true and correct. So help me God.

(Signature) Claude J. Dillon

402 Brown Bldg., Wichita, Kansas.  
(Address)

SUBSCRIBED AND SWORN to before me this 1st day of July, 1939.

My commission expires July 30, 1942

Bessie M. [Signature] Notary Public.

## WELL LOG

Bradley Oil Co., H. Ruhl #1.  
Section 24-19-10 Rice Co., Kans.

Drilling Commenced June 13, 1939  
Drilling Completed June 30, 1939  
Rotary Tools

Contractor: The Triangle Drilling Co.,  
Surface Casing: 10 $\frac{1}{4}$ " O.D. Set at 207'  
w/90 sack cement  
one-fourth off one degree off vertical.

0-85	Sand
85-220	Shale & shells
220-290	Red Bed
290-395	Red Bed & shale
395-420	Anhydrite & Lime
420-695	Shale & Shells
695-750	Anhydrite
750-995	Shale & Shells
995-1220	Salt & Shale
1220-1320	Anhydrite
1320-1415	Lime & shale
1415-1520	Shale & Lime
1520-1540	Sandy Lime
1540-1578	Sand-Sand rock
1578-1610	Shale & Lime
1610-1690	Lime & Shale
1690-1740	Broken Lime
1740-1880	Lime-shale
1880-2345	Shale-Lime
2345-2415	Shale-shells
2415-2535	Shale-lime
2535-2770	Lime
2770-2790	Lime & shale
2790-2925	Shale & lime
2925-3235	Lime
3235-3283	Conglomerate
3283-3293	Conglomerate & chert-cored
3293-3300	Chert & green shale
3300-3316	Conglomerate
3316-3352	Arbuckle

Porosity and no shows

I hereby certify the above log to be true and correct to the best of my knowledge

THE TRIANGLE DRILLING CO.,

By Arthur J. Sullivan

PLUGGING	
FILE SEC	24-19-100
BOOK PAGE	67 LINE 34

