


STATE OF KANSAS
STATE CORPORATION COMMISSION

WELL PLUGGING RECORD

Give All Information Completely
Make Required Affidavit
Mail or Deliver Report to
Conservation Division
State Corporation Comm.
245 North Water
Wichita, KS 67202

Rice County, Sec. 22 Twp. 19S Rge. 10 E/W
Location as "NE/CNW $\frac{1}{4}$ SW $\frac{1}{4}$ " or footage from lines
SE/4 SW/4 SE/4
Lease Owner Buckeye Energy, Inc.
Lease Name Marion Well No. 22-1
Office Address 226 Western United Life Bldg., Midland, Texas
Character of Well (Completed as Oil, Gas or Dry Hole) Dry Hole
Date Well completed November 6 1980
Application for plugging filed 11-6 1980
Application for plugging approved 11-6 1980
Plugging commenced 11-6 1980
Plugging completed 11-6 (7:00 P.M.) 1980
Reason for abandonment of well or producing formation Dry hole
If a producing well is abandoned, date of last production 19

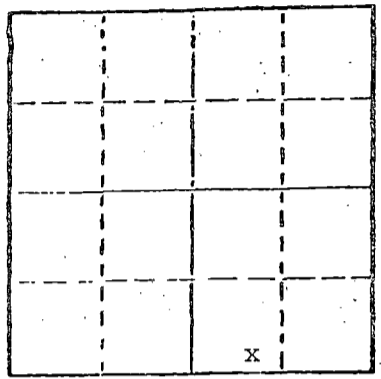

Locate well correctly on above Section Plat

Was permission obtained from the Conservation Division or its agents before plugging was commenced? Yes

Name of Conservation Agent who supervised plugging of this well Gilbert Toman
Producing formation NONE Depth to top Bottom Total Depth of Well 3302'
Show depth and thickness of all water, oil and gas formations.

OIL, GAS OR WATER RECORDS

CASING RECORD

FORMATION	CONTENT	FROM	TO	SIZE	PUT IN	PULLED OUT

Describe in detail the manner in which the well was plugged, indicating where the mud fluid was placed and the method or methods used in introducing it into the hold. If cement or other plugs were used, state the character of same and depth placed, from feet to feet for each plug set.

8-5/8" -- 260' 75 sacks of cement. Hole filled with mud. 50 sacks cement pumped through drill pipe at 450'. 30 sacks cement pumped through drill pipe at 240'. Hole filled with mud to 40'. Plug and 1/2 sack hulls pushed to 40' and hole cemented to base of cellar with 10 sacks cement.

(If additional description is necessary, use BACK of this sheet)

Name of Plugging Contractor Salazar Bros. Drilling, Inc. and Halliburton Co.

STATE OF TEXAS COUNTY OF MIDLAND, ss.
M. C. Durfee, President of Buckeye Energy, Inc. (employee of owner) or (owner or operator) of the above-described well, being first duly sworn on oath, says: That I have knowledge of the facts, statements, and matters herein contained and the log of the above-described well as filed and that the same are true and correct. So help me God.

(Signature) M. C. Durfee
226 Western United Life Bldg., Midland, Texas
(Address) 79701

SUBSCRIBED AND SWORN TO before me this _____ day of November, 1980

Judy Simmons
Judy Simmons Notary Public.

My commission expires 10-7-84

RECEIVED
STATE CORPORATION COMMISSION

DEC - 1 1980

CONSERVATION DIVISION
Wichita, Kansas

12-1-1980