

STATE OF KANSAS
STATE CORPORATION COMMISSION

Give All Information Completely
Make Required Affidavit
Mail or Deliver Report to:
Conservation Division
State Corporation Commission
800 Bittig Building
Wichita, Kansas

NORTH

**Locate well correctly on above
Section Plat**

WELL PLUGGING RECORD OR FORMATION PLUGGING RECORD

Strike out upper line when reporting plugging off formations.

Rice County, Sec. 20 Twp. 19S Rge. 10 (E) W (W)
 "NE $\frac{1}{4}$ NW $\frac{1}{4}$ SW $\frac{1}{4}$ " or footage from lines NE corner of SW $\frac{1}{2}$ of above:

Lease Owner.....	Texon Oil and Land Company	
Lease Name.....	Ernst Roth	Well No. 1
Office Address.....	P. O. Box 1267, Ponca City, Oklahoma	
Character of Well (completed as Oil, Gas or Dry Hole).....	Dry Hole	
Date well completed.....	7-19,	19 43
Application for plugging filed.....	7-19,	19 43
Application for plugging approved.....	7-19,	19 43
Plugging commenced.....	7-20,	19 43
Plugging completed.....	7-20,	19 43
Reason for abandonment of well or producing formation.....	Dry Hole	

If a producing well is abandoned, date of last production No production 19.....
Was permission obtained from the Conservation Division or its agents before plugging was com-
menced? Yes

Name of Conservation Agent who supervised plugging of this well Mr. R. Durkey, McPherson, Kansas
Producing formation Arbuckle Lime Depth to top 3350' Bottom 3379' Total Depth of Well 3379' Feet
Show depth and thickness of all water, oil and gas formations.


OIL, GAS OR WATER RECORDS

CASING RECORD

[illegible]

Describe in detail the manner in which the well was plugged, indicating where the mud fluid was placed and the method or methods used in introducing it into the hold. If cement or other plugs were used, state the character of same and depth placed, from feet to feet for each plug set.

The hole was filled with heavy mud to within 210' of the top where a wood plug was set and cemented with 15 sacks of cement to 200'. The hole was then filled with heavy mud to within 8' of the top where a wood plug was set and cemented with 5 sacks of cement to within 2' of the top where a steel cap was welded on the 10-3/4" OD casing.

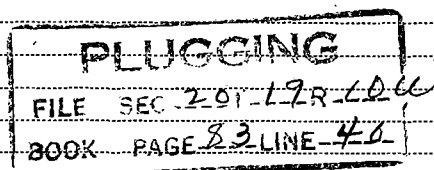

(If additional description is necessary, use BACK of this sheet)

Correspondence regarding this well should be addressed to Mr. F. L. Dunn 7-24-1943
Address R. F. D. #4, Lyons, Kansas

STATE OF Kansas, COUNTY OF Rice, ss.
Wm. Drassen (employee of owner) or (owner or operator) of the above-described well,
being first duly sworn on oath, says: That I have knowledge of the facts, statements, and matters herein contained and the log of the above-described well as filed and that the same are true and correct. So help me God.

(Signature) Wm Kramer Ass't. Dist. Sup't.

R. F. D. #4, Lyons, Kansas
(Address)

SUBSCRIBED AND SWORN TO before me this 22nd day of July, 1943

My commission expires October 21st, 1944.

WmD-RDM
Corp. Comm. ✓
LPC
Stanolind
File

19-4174

6-42--6M

Notary Public

WELL RECORD

Ernst Roth Well No. 1

Date Spudded: June 30, 1943
 Drilg. Completed: July 19, 1943
 Plugged: July 20, 1943

Loc: NE corner of the SW 1/4 of
 Sec. 20, Twp. 19S, Rge. 10W, in
 Rice County, Kansas.

From	To	Formation	From	To	Formation
0	73	Surface Clay	2374	2539	Lime
73	98	Water sand	2539	2622	Broken lime
98	110	Shale	2622	2971	Lime
110	203	Shale & shells	2971	2997	Shale & shells
203	303	Red Bed	2997	3273	Lime
303	418	Shale & shells	3273	3305	Shale & shells
418	460	Red Bed	3305	3313	Shale
460	489	Anhydrite	3313	3317	Sand & lime
489	996	Shale & shells	3317	3324	Shale
996	1270	Shale	3324	3330	Conglomerate
1270	1463	Broken lime	3330	3348	Arbuckle Dolomite
1463	2201	Shale & shells	3348	3379	Arbuckle
2201	2374	Broken lime	T. D.	3379	Arbuckle Lim

Elevation 1767'

Ran 200' of 10-5/4" OD 32# 3 Gauge Arisco Spiral Weld casing; set at 201'6"; cemented with 200 sacks of cement.


Top of Anhydrite - 460'.
 Top of Conglomerate - 3330'.
 Top of Arbuckle Lime - 3348'.

Drilled to 3379' in Arbuckle Lime - no show of oil.

Plugged and abandoned - July 20, 1943.

Total Depth - 3379' in the Arbuckle Lime formation.

Note: All above footages calculated from the ground level.

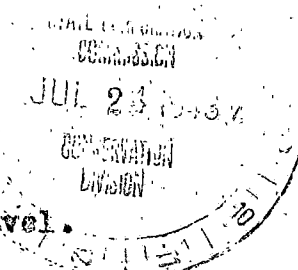

I, the undersigned, being first duly sworn upon oath, state that this Well Record is true, correct and complete according to the records in this office, and to the best of my knowledge and belief.

Wm Diener
 Assistant District Superintendent

Subscribed and sworn to before me this 22nd day of July, 1943.

My Commission expires October 21st, 1944.

Louis M. Quinn
 Notary Public

WHD-RUE 7/22/43
 State Corporation Comm. (1)
 LFC (3) Stanolind Oil & Gas Co. (1)
 File (1)

PLUGGING
 FILE SEC 20 19 10W
 BOOK PAGE 83 LINE 40