

STATE OF KANSAS
STATE CORPORATION COMMISSION

WELL PLUGGING RECORD


Give All Information Completely
Make Required Affidavit
Mail or Deliver Report to:
Conservation Division
State Corporation Commission
800 Mining Building
Wichita, Kansas

OR
FORMATION PLUGGING RECORD

Strike out upper line
when reporting plug-
ging off formations.

Rice County. Sec. 16 Twp. 19 Rge. 10 (W)

Location as "NE $\frac{1}{4}$ NW $\frac{1}{4}$ SW $\frac{1}{4}$ " or footage from lines NE NE NE
Lease Owner Flournoy & Williams, et al
Lease Name Hammel Well No. 1
Office Address Box 270 Hoisington, Kansas
Character of Well (completed as Oil Gas or Dry Hole) D & A
Date well completed 9-10-48 19
Application for plugging filed 9-10-48 19
Application for plugging approved ~~9-10-48~~ 19
Plugging commenced 9-10-48 19
Plugging completed 9-10-48 19
Reason for abandonment of well or producing formation D & A

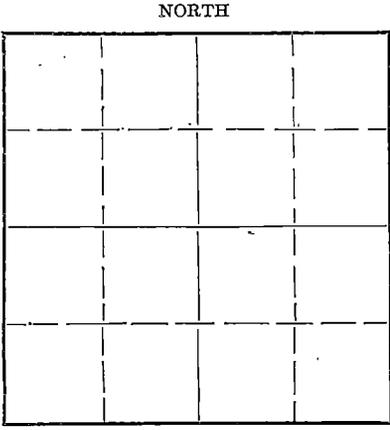

Locate well correctly on above
Section Plat

If a producing well is abandoned, date of last production 19
Was permission obtained from the Conservation Division or its agents before plugging was com-
menced YES

Name of Conservation Agent who supervised plugging of this well Mr. Durhee
Producing formation K.C. Depth to top 2990 Bottom 3095 Total Depth of Well 3095 Feet
Show depth and thickness of all water, oil and gas formations.

OIL, GAS OR WATER RECORDS

CASING RECORD

Formation	Content	From	To	Size	Put In	Pulled Out
Surface	sand-clay	-0-	198	8-5/8	198	-0-

Describe in detail the manner in which the well was plugged, indicating where the mud fluid was placed and the method or methods used in introducing it into the hole. If cement or other plugs were used, state the character of same and depth placed, from feet to feet for each plug set.

Filled hole with heavy mud 2895' from bottom

Spotted 15 sax cement @ 200'

Spotted 5 sax cement @ top

(If additional description is necessary, use BACK of this sheet)

Correspondence regarding this well should be addressed to Box 270, Hoisington, Kansas
Address

STATE OF KANSAS, COUNTY OF SEDGWICK, ss.
Chester Williams, Partner (employee of owner) or (owner or operator) of the above-described well,
being first duly sworn on oath, says: That I have knowledge of the facts, statements, and matters herein contained and the log of the above-
described well as filed and that the same are true and correct. So help me God.


(Signature) *Chester Williams*

Wichita, Kansas (Address)

SUBSCRIBED AND SWORN TO before me this 14th day of September 1948

My commission expires Nov 3, 1948

Notary Public.

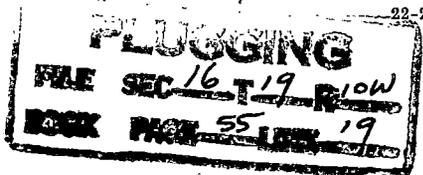

KANSAS WELL LOG BUREAU --- KANSAS GEOLOGICAL SOCIETY

412 UNION NATIONAL BANK BUILDING - WICHITA, KANSAS

COMPANY Flournoy & Williams, et al

SEC. 16 T. 19 R. 10W.

FARM Hammel

NO. 1

LOC. NE NE NE

TOTAL DEPTH 3095

COUNTY Rice


COMM. 8-3048

COMP. 9-10-48

SHOT OR TREATED ~~XXXXXXXXXX~~

CONTRACTOR Company Tool

ISSUED 9-14-1948

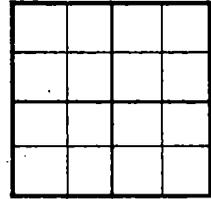

CASING

20	10
15 1/2	8 1/4 198'
12 1/2	6 3/4
13 3/4	5 1/4

ELEVATION

PRODUCTION D & A

FIGURES INDICATE BOTTOM OF FORMATIONS

Sand	40
Sand and Clay	198
Shells	210
Red Bed and Shale	715
Shale and shells	940
Shale	1040
Salt	1200
Shale and shell	1320
Shale and lime	1480
Lime	1585
Shale	1613
Sand	1640
Lime	1835
Lime and shale	1975
Lime	2060
Lime and shale	2460
Lime	2765
Lime and shale	2825
Lime	2880
Lime and shale	3055
Lime	3095 T.D.

GEOLOGICAL TOPS

2899 Top of Douglas Sand
 2966 Top of Brown Lime
 2990 Top of Lansing-K.C.
 3095 T.D. Top of Rotary Bushing
 4' above Ground Level

COUNTY OF SEDGWICK)
) SS:
 STATE OF KANSAS)

Chester Williams, of lawful age, being first duly sworn under oath, states that Flournoy & Williams was the contractor engaged for the drilling of Hammel #1 and that the foregoing is a true and correct copy of the drillers' log of the above well.

Chester Williams

Subscribed and sworn to before me, a notary public, in and for said County and State, this 14 day of September, 1948.

My commission expires Nov 3, 1948 *Nola Boyd*

 Notary Public

SEP 14 1948

PLUGGING
 FILE SEC 16 T 19 R 10W
 BOOK PAGE 55 LINE 19